IREDELL COUNTY HEALTH DEPARTMENT

STATESVILLE 704-878-5305 MOORESVILLE 704-664-5281

IMPROVEMENT PERMIT / ~~CERTIFICATE OF COMPLETION~~ / OPERATION PERMIT / EXISTING SYSTEM INSPECTION

We have gotten to Contract

PROPERTY DESCRIPTION NO. 15675 DATE 5/29/97 TAX MAP NO. 4G-4-A-28 Watershed: [X] Yes [ ] No

OWNER OR CONTRACTOR Mel Graham PHONE: Business 552-5338 ~~Home~~ 4760-09-0159

ADDRESS 7701 Park Rd. Charlotte, NC. 28210

LOCATION Weathers Crk. TL on Single Oak Dr. lot on (E) corner

SUBDIVISION Pleasant Run BLOCK / SECTION ____ LOT 28 LOT AREA .72 SITE CLASS. PS DESIGN FLOW 360 L.T.A.R. .25

Septic Tank: 1000 Gallons; STB 794 Date 6/22/98

Pump Tank: ____ Gallons; PT ____ Date ____

Pump Make: ____ Model ____ Serial No. ____

Nitrification Field: No Fields 1 Square Feet 1080 Linear Feet 360

No Lines 3 Trench Width 36" Max Trench Bottom Depth 3 Gravel Depth SAND.

[X] New System [ ] Repair System Type: I, II, (III) IV, V, VI

System Description: GR-CH PLASTIC

Repair System Description: GR 16" PBS

Maintenance Agreement Required: [ ] Yes [ ] No

[X] House/Mod. Home No. Bedrooms 3

[ ] Mobile Home No. Bathrooms 2

[ ] Business No. Employees ____

[ ] Other ____

[ ] Slab [X] Crawl Space [ ] Basement w/plumbing [ ] Basement wo/plumbing


Water Supply:
[X] Individual
[ ] Community
[ ] Public

Comments: Plumbing needs

Comments:

1" = 50'

INITIAL SITE SKETCH

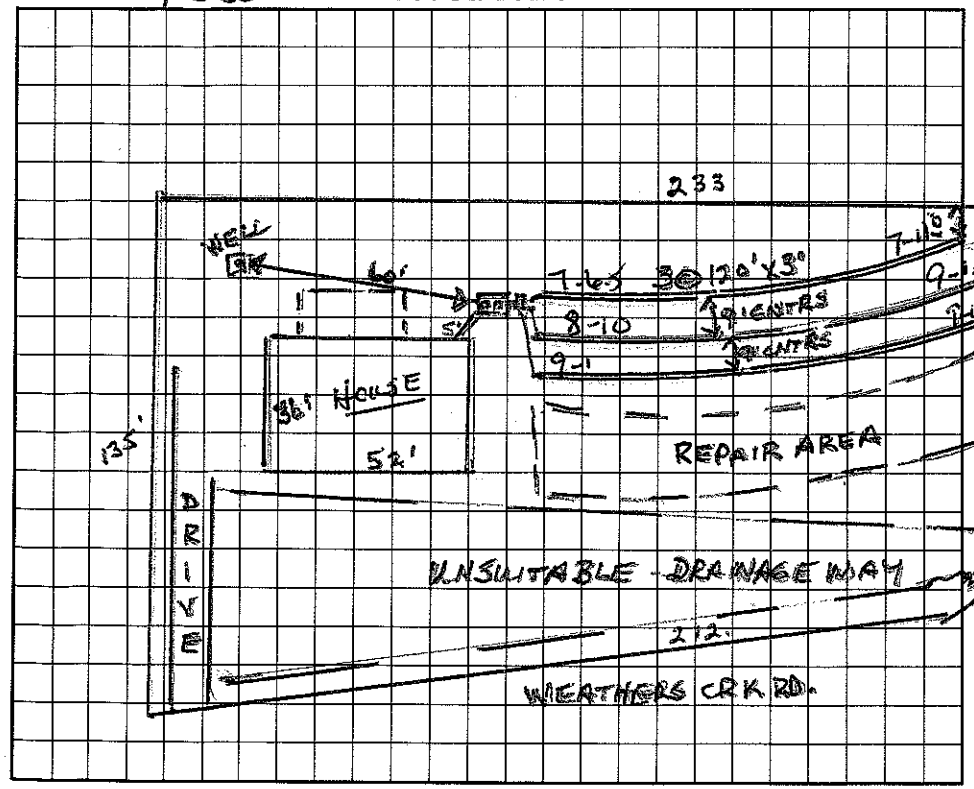

AS BUILT SKETCH

I understand that this permit can be suspended or revoked if any false information is supplied toward securing the permit/any unauthorized changes are made to the site/any unauthorized changes are made in the installation of the system. Improvement Permit is valid for 60 months from date of issuance.

Signed: [signature]

Improvement Permit by: Wesley Sparks R.S. date 5/29/97

Existing System Inspection by: Wesley Sparks R.S. date 5/29/97

Installed by: Levon Benton

Certificate of Completion by: Wesley Sparks R.S. date 9/29/98

Operation Permit by: ____ date ____

HEALTH DEPT. COPY: WHITE INSPECTION COPY (FINAL): GREEN OWNER COPY (FINAL): YELLOW INSPECTION COPY (INITIAL): PINK OWNER COPY (INITIAL): GOLD