IREDELL COUNTY HEALTH DEPARTMENT *ENVIRONMENTAL HEALTH DIVISION*:

SITE PLAN WORKSHEET

SEE THE "SAMPLE SITE PLAN" BELOW. ***INCOMPLETE SITE PLANS WILL BE RETURNED TO YOU FOR COMPLETION AND MAY RESULT IN A DELAY IN THE ISSUANCE OF YOUR SEPTIC SYSTEM PERMIT!!!***

Place an (X) beside each item as you complete the site plan:

✓ **Property Line measurements are clearly identified...** ✓ **All proposed structures are indicated...**

SHOW: proposed house or business footprint, wells, water lines, patios, pools and decks, and any other item that will occupy space on the site


✓ **Front and side setbacks from property line...** ✓ **Preferred driveway location and configuration, preferred well location...**

✓ **Area you prefer your septic system to be placed...** ____ **North arrow, or other sufficient indicator of direction...**

Circle N/A on the following if appropriate:


N/A **Location of septic systems and wells within 100' of your property... N/A**

N/A **Location of easements and rights of ways on your property... N/A** ____ **Location of any designated wetlands on the property... N/A**

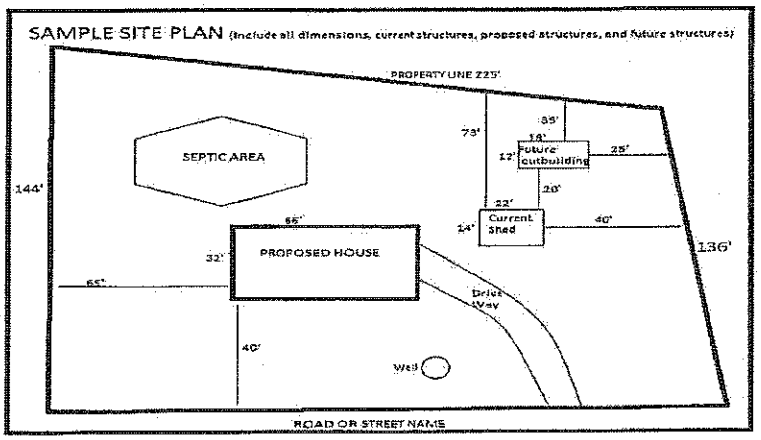

USE THIS SPACE TO DRAW YOUR SITE PLAN

See Attached

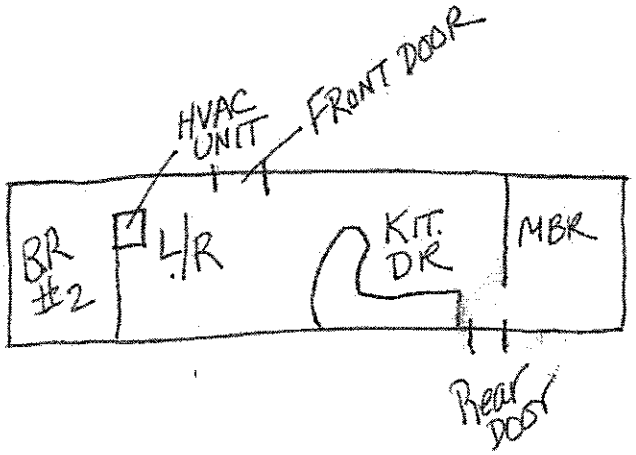

Signature: Kathleen Mayo

REQUIRED property owner or owner's legal representative signature.

DATE

ELL COUNTY HEALTH DEPARTMENT

STATESVILLE 704-878-5305 MOORESVILLE 704-664-5281

OVEMENT PERMIT / AUTHORIZATION TO CONSTRUCT / OPERATION PERMIT / EXISTING SYSTEM INSPECTION

125.00 Paid 10:00

0956666 PIN# ~~4760 11 5254~~ 4760-15-2192 DATE 5/9/01

CONTRACTOR Joel R. Howard PHONE: Business 704-892-3152 Home

18400 Shedrick Rd. Davidson, NC. 28036

115-21N TR Shinnville Rd TL Weathers Creek Rd X creek on (L) at top of hill

Country View BLOCK / SECTION 3 LOT 17 LOT AREA .6 SITE CLASS PS DESIGN FLOW 360 L.T.A.R. .3

c 1000 Gallons; STB 1012 Date 3/3/01

Gallons; PT Date

Model Serial No.

Field: No Fields 1 Square Feet 900 Linear Feet 300

3@100' Trench Width 3' Max Trench Bottom Depth 3' Gravel Depth No

☒ New System ☐ Repair System Type: I, II, (III) IV, V, VI

System Description: 25% Reduction - Shared

Repair System Description: Sewer

Maintenance Agreement Required: ☐ Yes ☒ No

☐ House/Mod. Home No. Bedrooms 3

☒ Mobile Home No. Bathrooms 2

☐ Business No. Employees

☐ Other


☐ Slab ☐ Crawl Space ☐ Basement w/plumbing ☐ Basement wo/plumbing

Water Supply: ☐ Individual ☐ Public ☒ Community


Conditions:

Comments/Conditions: In Filtrators Installed

(1" = 50') INITIAL SITE SKETCH

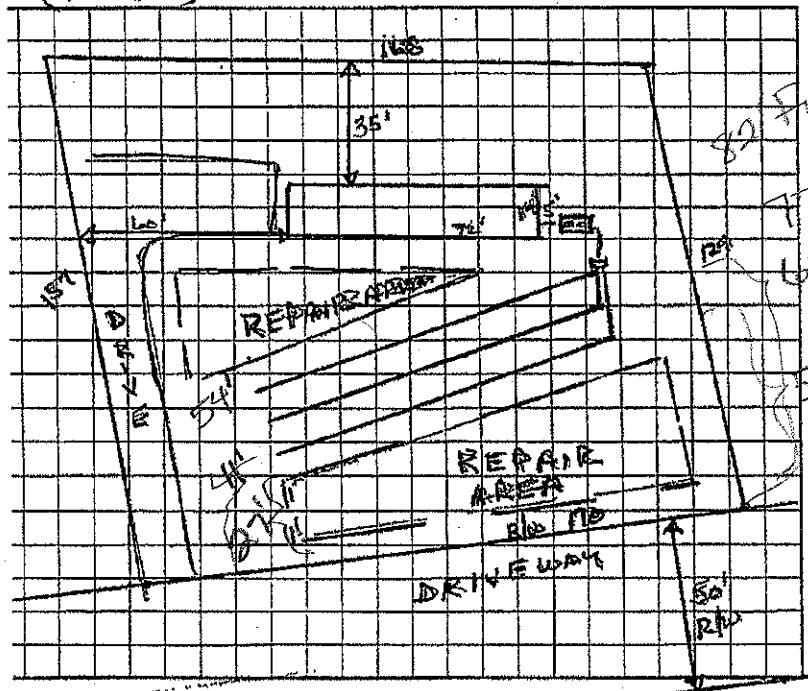

AS BUILT SKETCH

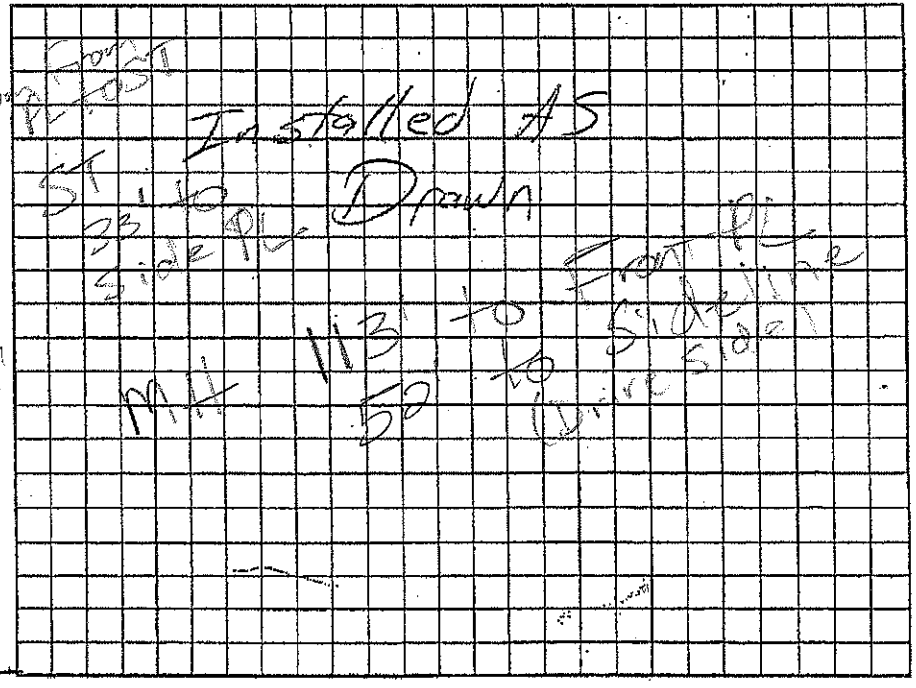

Be suspended or revoked if any false information is supplied toward securing the permit/any unauthorized changes are made to the site/any unauthorized changes are made in the installation of the system. Improvement plat valid without expiration. Improvement Permit with site plan valid for sixty months. Authorization to Construct is valid for a period equal to that of Improvement Permit – not to exceed sixty months.

X Joel R. Howard date 5-9-01 Installed by: A-1 Backhoe

nt Permit by: Wesley Sparks R.S. date 5/9/01 Operation Permit by: [signature] LST date 5/15/01

n to Construct by: Wesley Sparks R.S. date 5/9/01 Existing System Inspection by: date

HEALTH DEPT. COPY: WHITE OWNER COPY (FINAL): YELLOW OWNER COPY (INITIAL): PINK