IREDELL COUNTY HEALTH DEPARTMENT

STATESVILLE 704-878-5305 MOORESVILLE 704-664-5281

IMPROVEMENT PERMIT / AUTHORIZATION TO CONSTRUCT / OPERATION PERMIT / EXISTING SYSTEM INSPECTION

PERMIT# 071357 PIN# 4760175284 PT DATE 3/9/98

OWNER OR CONTRACTOR Howard & Assoc. PHONE: Business 892-3152 Home

ADDRESS 18400 Shearer Rd Davidson, NC 28036

LOCATION Hwy 115/21 TR Shinnville Rd, TL Weathers Creek, TL Sydney Ln on left

SUBDIVISION Countryview Est BLOCK / SECTION LOT 4 LOT AREA SITE CLASS. PS DESIGN FLOW 360 gpd L.T.A.R. .3

Septic Tank: 1000 Gallons; STB 794 Date 6/30/98
Pump Tank: Gallons; PT Date
Pump Make: Model Serial No.
Nitrification Field: No Fields 1 Square Feet 1200' Linear Feet 400'
No Lines 5 at 80' Trench Width 36" Max Trench Bottom Depth 36" Gravel Depth 12"

☒ New System ☐ Repair System Type: I, II, III, IV, V, VI
System Description: Gravity - Conventional
Repair System Description: Conventional
Maintenance Agreement Required: ☐ Yes ☒ No

☐ House/Mod. Home No. Bedrooms 3
☒ Mobile Home No. Bathrooms 2
☐ Business No. Employees
☐ Other
☐ Slab ☐ Crawl Space ☐ Basement w/plumbing ☐ Basement wo/plumbing


Water Supply: ☒ Individual ☐ Public ☐ Community Multi-Connect

Comments:/Conditions: Keep Septic System at least 10' from PL & 5' from House


As Built

Comments:/Conditions: REDRAW

~~INITIAL SITE~~ SKETCH Scale 1:50

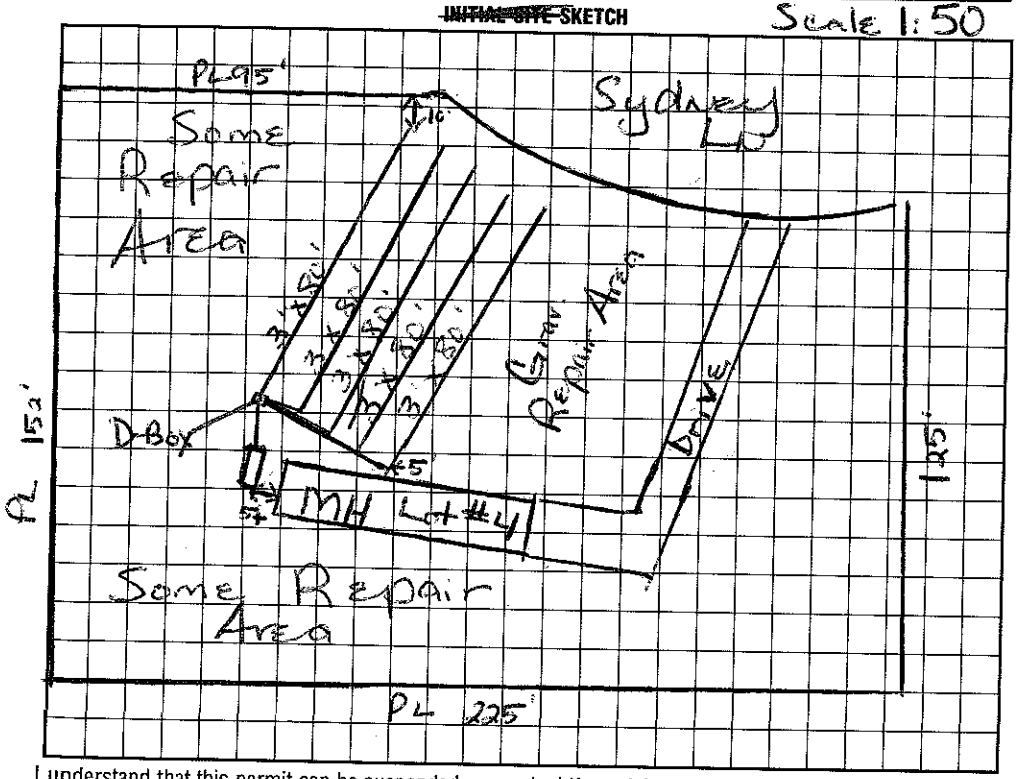

AS BUILT SKETCH

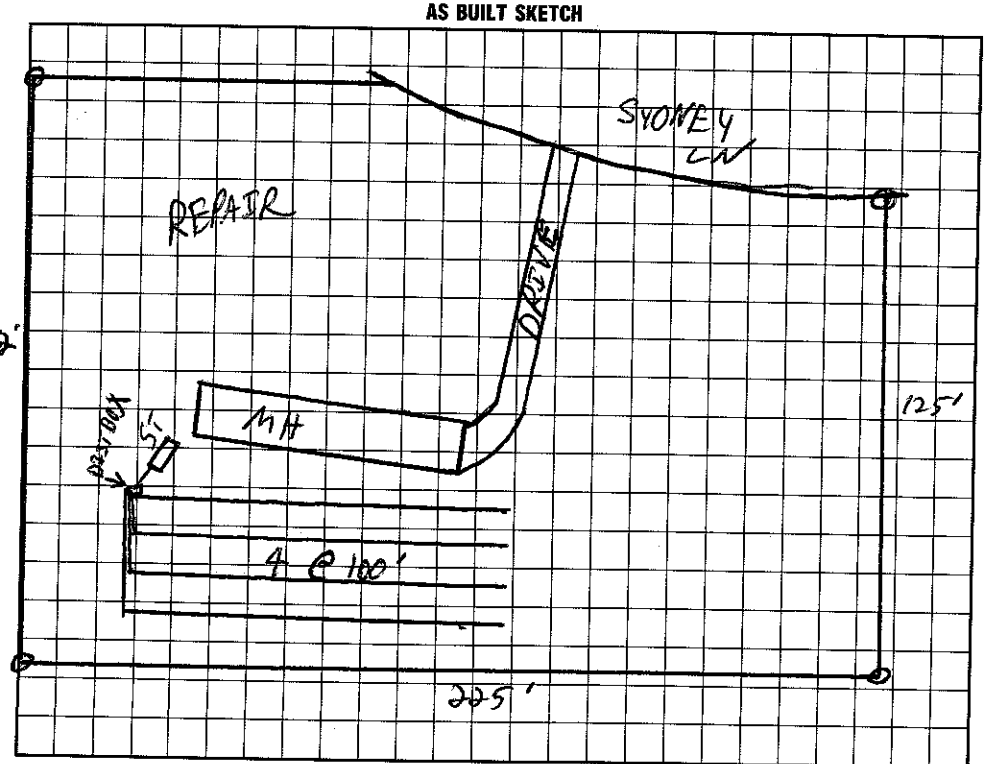

I understand that this permit can be suspended or revoked if any false information is supplied toward securing the permit/any unauthorized changes are made to the site/any unauthorized changes are made in the installation of the system. Improvement Permit with plat valid without expiration. Improvement Permit with site plan valid for sixty months. Authorization to Construct is valid for a period equal to that of Improvement Permit – not to exceed sixty months.

Signed: Neal R. Howard date 3-12-98
Improvement Permit by: Marion H. Dotson date 3/9/98
Authorization to Construct by: Marion H. Dotson date 3/9/98

Installed by: LARRY BEAN
Operation Permit by: C. [illegible] date 9/15/98
Existing System Inspection by: date

HEALTH DEPT. COPY: WHITE INSPECTION COPY (FINAL): GREEN OWNER COPY (FINAL): YELLOW INSPECTION COPY (INITIAL): PINK OWNER COPY (INITIAL): GOLD