IREDELL COUNTY HEALTH DEPARTMENT

STATESVILLE 704-878-5305 125.00 Paid MOORESVILLE 704-664-5281

IMPROVEMENT PERMIT / AUTHORIZATION TO CONSTRUCT / OPERATION PERMIT / EXISTING SYSTEM INSPECTION

PERMIT# 094400 PIN# ~~4760 17 5284 PF.~~ 4760-15-3910 DATE 2/12/01

OWNER OR CONTRACTOR Joel Howard PHONE: Business 892-3152 Home

ADDRESS 18400 Athens Rd. Davidson, NC. 28036

LOCATION 115-2 N TR-Statesville Rd. TL Weathers Creek Rd. on L 2nd Post Hubris Ln.

SUBDIVISION County View Estates BLOCK / SECTION LOT 15 LOT AREA .53 Ac SITE CLASS. PS DESIGN FLOW 360 L.T.A.R. .3

Septic Tank: 1000 Gallons; STB 1012 Date 11/4/00
Pump Tank: Gallons; PT Date
Pump Make: Model Serial No.
Nitrification Field: No Fields 1 Square Feet 900 * Linear Feet 300 *
No Lines 4 @ 75' Trench Width 3' Max Trench Bottom Depth 3'

[X] New System [ ] Repair System Type: I, II, [III], IV, V, VI
System Description: GRAV - CH. PLASTIC
Repair System Description: SAME
Maintenance Agreement Required: [ ] Yes [X] No
~~Gravel~~ Depth No

[ ] House/Mod. Home [X] Mobile Home [ ] Business [ ] Other
No. Bedrooms 3 No. Bathrooms 2 No. Employees

[ ] Slab [X] Crawl Space [ ] Basement w/plumbing [ ] Basement wo/plumbing


Water Supply: [X] Individual [ ] Public [ ] Community

Comments:/Conditions:

Comments:/Conditions:

(1" = 50')

INITIAL SITE SKETCH

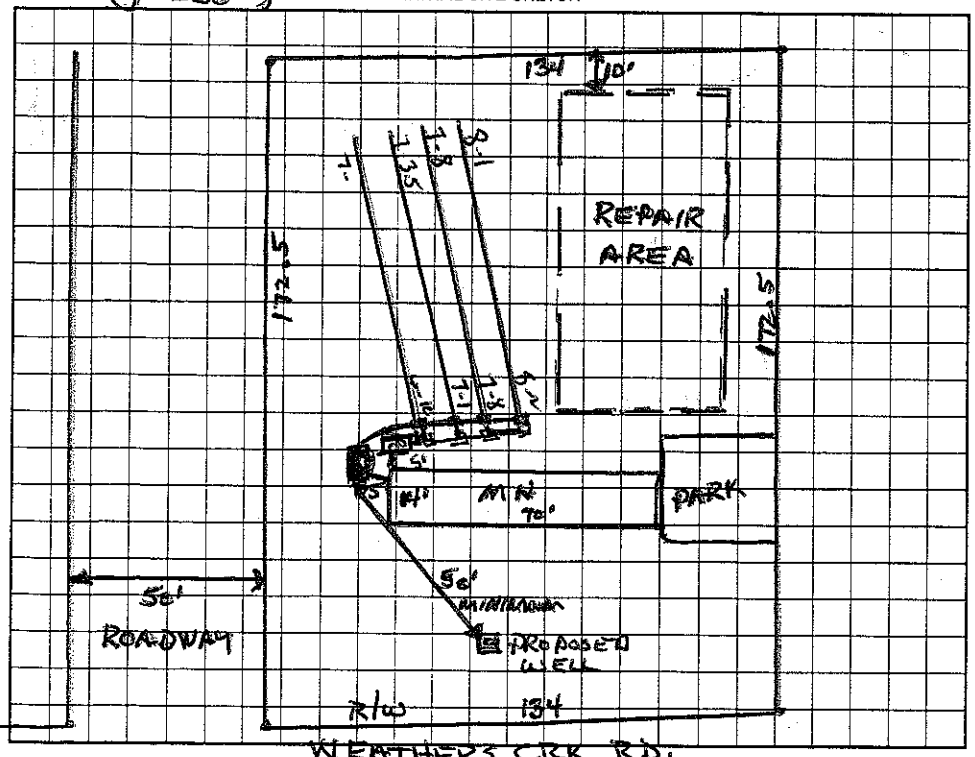

AS BUILT SKETCH

Permit can be suspended or revoked if any false information is supplied toward securing the permit/any unauthorized changes are made to the site/any unauthorized changes are made in the installation of the system. Improvement Permit with plat valid without expiration. Improvement Permit with site plan valid for sixty months. Authorization to Construct is valid for a period equal to that of Improvement Permit – not to exceed sixty months.

Signed: Joel R. Howard date 2/16/01 Installed by: A-1 Backhoe

Improvement Permit by: Wesley Sparks RS. date 2/12/01 Operation Permit by: Wesley Sparks RS date 2/20/01

Authorization to Construct by: Wesley Sparks RS. date 2/12/01 Existing System Inspection by: date

HEALTH DEPT. COPY: WHITE OWNER COPY (FINAL): YELLOW OWNER COPY (INITIAL): PINK