IREDELL COUNTY HEALTH DEPARTMENT

STATESVILLE 704-878-5305 (1) MOORESVILLE 704-664-5281

IMPROVEMENT PERMIT / AUTHORIZATION TO CONSTRUCT / OPERATION PERMIT / EXISTING SYSTEM INSPECTION

PERMIT# 094271 PIN# ~~4760 TT 5284~~ 4760-15-4735 DATE 2/12/01

OWNER OR CONTRACTOR Joel Howard PHONE: Business 892-3152 Home

ADDRESS 18400 Sheeans Rd. Davidson, NC. 28036

LOCATION 115-21N TR-Statesville Rd. TL Weathers Creek Rd. ~ 1 mile on (L)

SUBDIVISION Country View Est. BLOCK / SECTION B LOT 14 LOT AREA .67 SITE CLASS. PS DESIGN FLOW 360 L.T.A.R. .3

Septic Tank: 1000 Gallons: STB 1017 Date 11/1/00
Pump Tank: Gallons: PT Date
Pump Make: Model Serial No.
Nitrification Field: No Fields 1 Square Feet 1200 Linear Feet 400
No Lines ~~5080~~ Trench Width 3' Max Trench Bottom Depth 3' Gravel Depth 12"

[X] New System [ ] Repair System Type: I, (II), III, IV, V, VI
System Description: Gravity - Conventional
Repair System Description: 25% Reduced
Maintenance Agreement Required: [ ] Yes [X] No

[ ] House/Mod. Home No. Bedrooms 3
[X] Mobile Home No. Bathrooms 2
[ ] Business No. Employees
[ ] Other
[ ] Slab [X] Crawl Space [ ] Basement w/plumbing [ ] Basement wo/plumbing


Water Supply: [X] Individual [ ] Public [ ] Community

Comments:/Conditions: 6 lines varying lengths

Comments:/Conditions:

(1" = 50')

INITIAL SITE SKETCH

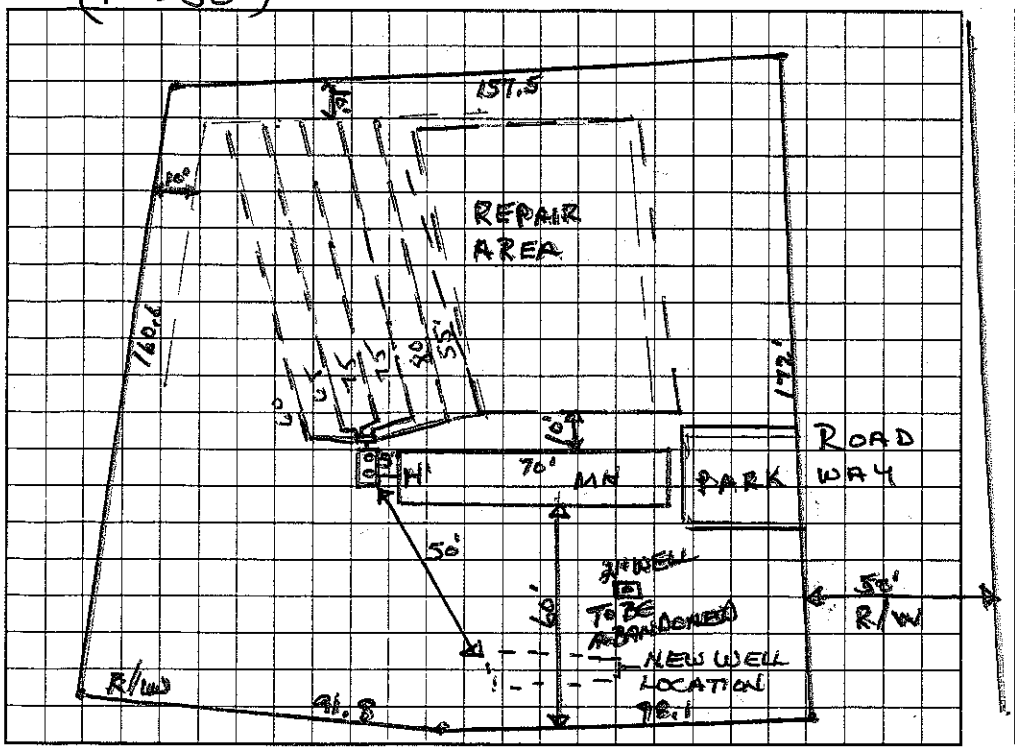

AS BUILT SKETCH

Permit can be suspended or revoked if any false information is supplied toward securing the permit/any unauthorized changes are made to the site/any unauthorized changes are made in the installation of the system. Improvement Permit with plat valid without expiration. Improvement Permit with site plan valid for sixty months. Authorization to Construct is valid for a period equal to that of Improvement Permit – not to exceed sixty months.

Signed: Jack R. Howard date 2/16/01 Installed by: A-1 Backhoe

Improvement Permit by: Wesley Sparks RS. date 2/12/01 Operation Permit by: Wesley Sparks RS. date 2/20/01

Authorization to Construct by: Wesley Sparks RS. date 2/12/01 Existing System Inspection by: date

HEALTH DEPT. COPY: WHITE OWNER COPY (FINAL): YELLOW OWNER COPY (INITIAL): PINK