IREDELL COUNTY HEALTH DEPARTMENT

STATESVILLE 704-878-5305 MOORESVILLE 704-664-5281

IMPROVEMENT PERMIT / AUTHORIZATION TO CONSTRUCT / OPERATION PERMIT / EXISTING SYSTEM INSPECT

PERMIT# 971356 PIN# ~~4760-75-2347~~ 4760-15-5005 DATE 3/9/98

OWNER OR CONTRACTOR Howard & Assoc. PHONE: Business 892-3152 Home

ADDRESS 18400 Shearer Rd. Davidson, NC 28036

LOCATION 115/21 N to Shinnville Rd TR to Weathers Creek Tr Sydney Ln Tr

SUBDIVISION Country View Est BLOCK / SECTION LOT 3 LOT AREA .56 Acre SITE CLASS. PS DESIGN FLOW 360 gpd L.T.A.R. .25 .3 Initial

Septic Tank: 1000 Gallons; STB 744 Date 6/24/97

Pump Tank: Gallons; PT Date

Pump Make: Model Serial No.

Nitrification Field: No Fields 1 Square Feet 1200 Linear Feet 405'

No Lines 7 Trench Width 36" Max Trench Bottom Depth 36" Gravel Depth 12"

☒ New System ☐ Repair System Type: I, II, III, IV, V, VI

System Description: Grav. - Conventional

Repair System Description: Grav./Pump Conventional

Maintenance Agreement Required: ☐ Yes ☒ No

☒ House/Mod. Home No. Bedrooms 3

☐ Mobile Home No. Bathrooms 2

☐ Business No. Employees

☐ Other


☐ Slab ☒ Crawl Space ☐ Basement w/plumbing ☐ Basement wo/plumbing

Water Supply: ☒ Individual ☐ Public ☐ Community Multi-Connect.


Comments:/Conditions: Must pull plumbing at high to avoid Pumping & maintain fall between tank & drainfield. (Repair area 25 LTAR @ 18" trenches)

Comments:/Conditions: REDRAW

INITIAL SITE SKETCH

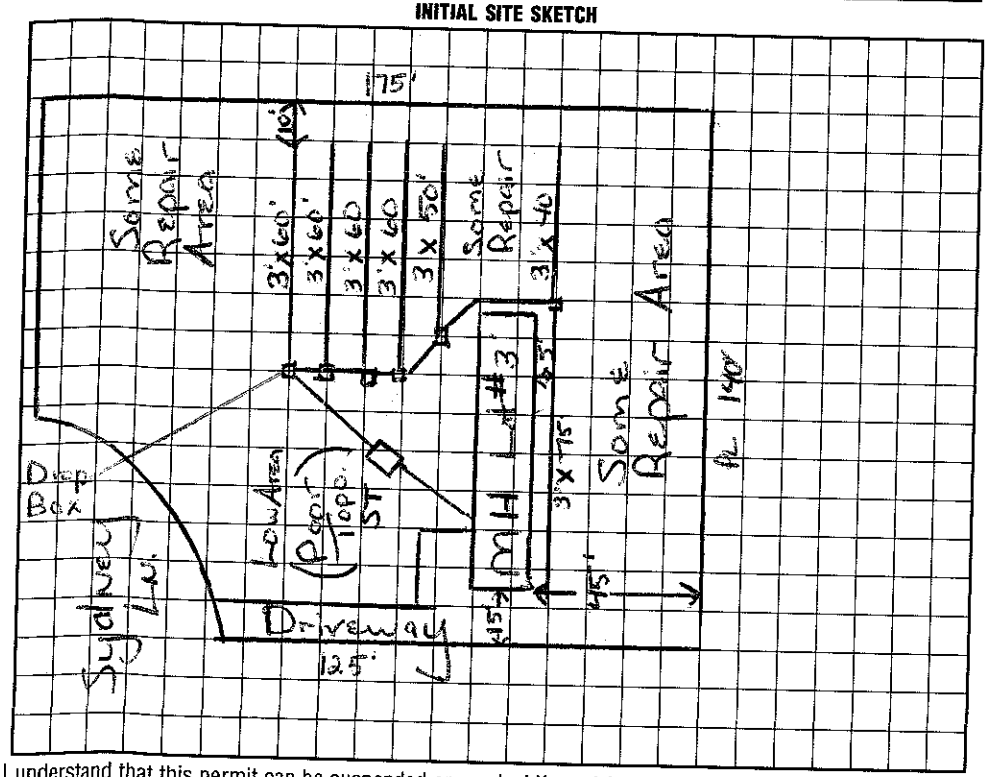

AS BUILT SKETCH

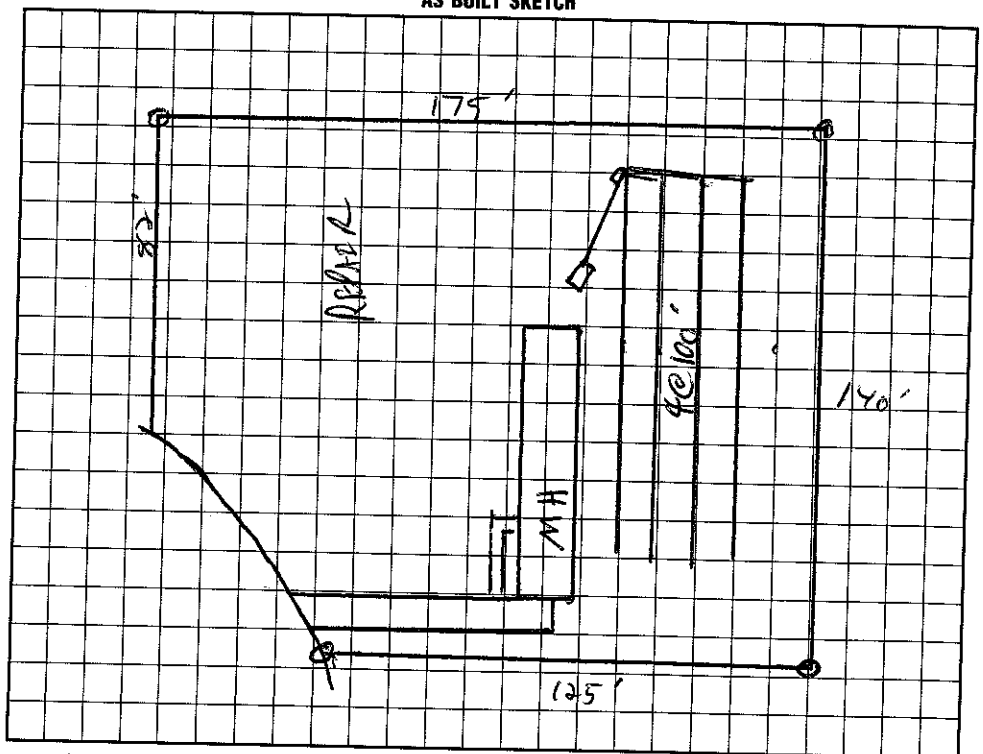

I understand that this permit can be suspended or revoked if any false information is supplied toward securing the permit/any unauthorized changes are made to the site/any unauthorized changes are made in the installation of the system. Improvement Permit with plat valid without expiration. Improvement Permit with site plan valid for sixty months. Authorization to Construct is valid for a period equal to that of Improvement Permit – not to exceed sixty months.

Signed: Joel R Howard date 3-12-98

Improvement Permit by: Marina H. Dotson date 3/9/98

Authorization to Construct by: Marina H. Dotson date 3/9/98

Installed by: CARLY BEAM

Operation Permit by: C. [illegible] date 9/15/98

Existing System Inspection by: date

HEALTH DEPT. COPY: WHITE INSPECTION COPY (FINAL): GREEN OWNER COPY (FINAL): YELLOW INSPECTION COPY (INITIAL): PINK OWNER COPY (INITIAL): GOLD