IREDELL COUNTY HEALTH DEPARTMENT

Statesville Office (704) 878-5305 | Mooresville Office (704) 660-3625 | PERMIT # 214284

IMPROVEMENT PERMIT / AUTHORIZATION TO CONSTRUCT / OPERATION PERMIT / EXISTING SYSTEM

PIN # 4760-15-5263

APPLICANT: DAVID EDWARDS | APPLICANT ADDRESS: 122 GREEN ACRES RD

SITE ADDRESS: 114 HUBIE LN. ; Iron. | PHONE: 704-236-0855 | ALT. PHONE:

SITE DIRECTIONS: WEATHERS CREEK, TL HUBIE, ON R

SUBDIVISION: COUNTRY VIEW ESTATES | SECTION: | LOT # 7 | LOT AREA: .53 AC | DESIGN FLOW: 360 | L.T.A.R.: .3

Septic Tank EX. 1000 (gal) | STB | Date

Pump Tank (gal) | PT | Date

Pump Make | Model | Serial #

Nitrification Fields | # Lines | Linear Ft:

Trench Width | Max Trench Bottom Depth | Gravel Depth 12"

☐ New System ☐ Repair ☐ Expansion System Type: I II III IV V VI

System Description: GRAVEL

Repair System Description: PANEL BLOCK

Maintenance Agreement Required: ☐ YES ☒ NO

☒ GRAVITY ☐ PRESSURE

☒ Residence ☐ Business ☐ Other ☐ Slab ☐ Basement w/plumbing

No. Bedrooms 3 | No. Persons | No. Employees | ☒ Crawl Space

Water Supply: ☐ Private ☐ Public ☒ Community


☐ Basement w/o plumbing

Comments / Conditions:

INITIAL SITE SKETCH

* EXISTING SYSTEM INSPECTION FOR 2 BED ROOM TRAILER.
* SYSTEM SIZED FOR 3 BEDROOMS

AS BUILT SKETCH

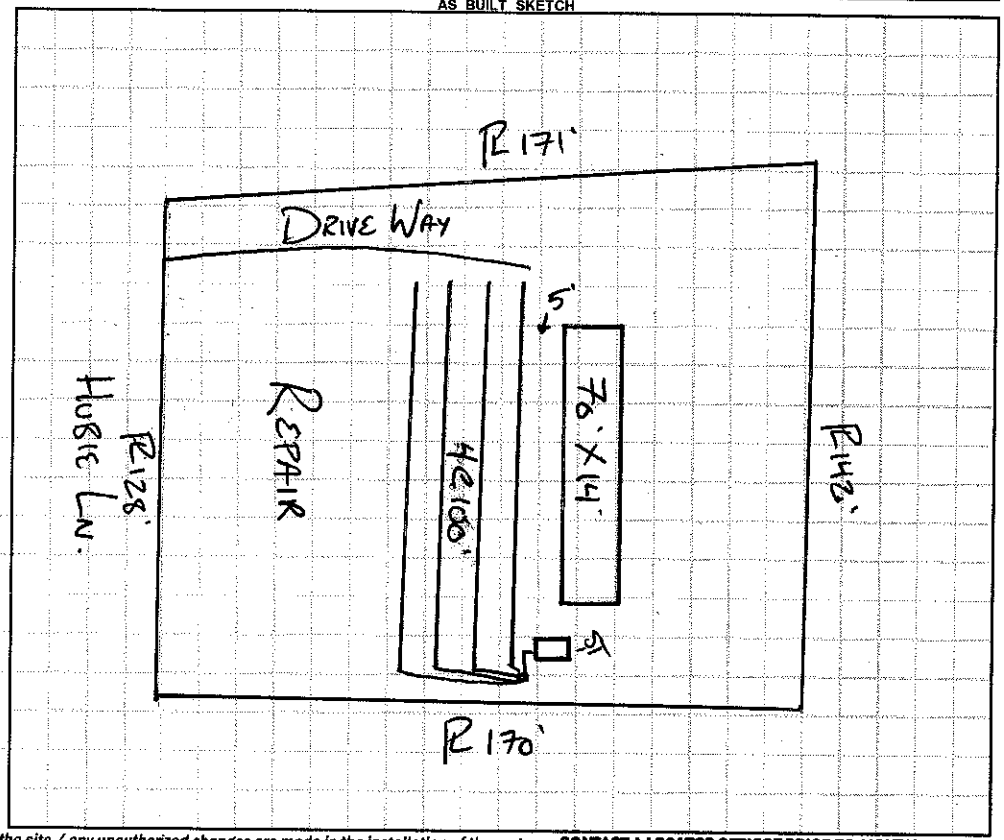

Permit can be suspended or revoked if any false information is supplied toward securing the permit / any unauthorized changes are made to the site / any unauthorized changes are made in the installation of the system. **CONTACT A LOCATOR SERVICE PRIOR TO ANY EXCAVATION**

☐ **IMPROVEMENT PERMIT** *with plat valid without expiration.* ☐ **IMPROVEMENT PERMIT** *with site plan valid for 60 mos.* ☐ **AUTHORIZATION TO CONSTRUCT** *valid for period equal to IMPROVEMENT PERMIT--not to exceed 60 mo.*

Owner / Applicant Signature: David Wayne Edwards | Date: 11-13-15 | Installed by:

IMPROVEMENT PERMIT by: | Date: | OPERATION PERMIT by: | Date:

AUTHORIZATION TO CONSTRUCT by: | Date: | Existing System Inspected by: R A Collins | Date: 11-9-15

Health Dept. Copy - WHITE | Applicant (Final Approval) - YELLOW | Applicant (Conditional Approval) - PINK