IREDELL COUNTY HEALTH DEPARTMENT

STATESVILLE 704-878-5305 MOORESVILLE 704-664-5281

IMPROVEMENT PERMIT / AUTHORIZATION TO CONSTRUCT / OPERATION PERMIT / EXISTING SYSTEM INSPECTION

PERMIT# 8124 PIN# ~~4760-74058-77~~ 4760-15-5631 DATE 8/4/99

OWNER OR CONTRACTOR JOEL HOWARD PHONE: Business _____ Home 892-3052

ADDRESS 18400 SHEARERS LD. DAVIDSON NC 28036

LOCATION 115N - TR SHINVILLE - TL WEATHERS CREEK - ON LT PAST CREEK

SUBDIVISION COUNTRY VIEW BLOCK / SECTION 2 LOT 11 LOT AREA .59AC SITE CLASS. PS DESIGN FLOW 360 L.T.A.R. .3

Septic Tank: 1000 Gallons; STB 1012 Date 10/15/99

Pump Tank: _____ Gallons; PT _____ Date _____

Pump Make: _____ Model _____ Serial No. _____

Nitrification Field: No Fields 1 Square Feet 1200 Linear Feet 400

No Lines 8@50' Trench Width 36" Max Trench Bottom Depth 36" Gravel Depth 12"

☑ New System ☐ Repair System Type: I (II) III, IV, V, VI

System Description: GRAVITY CONVENTIONAL

Repair System Description: PUMP CONVENSIONAL

Maintenance Agreement Required: ☐ Yes ☑ No

☐ House/Mod. Home No. Bedrooms 3

☑ Mobile Home No. Bathrooms 2

☐ Business No. Employees ____

☐ Other ____


☐ Slab ☑ Crawl Space ☐ Basement w/plumbing ☐ Basement wo/plumbing

Water Supply: ☐ Individual ☐ Public ☑ Community


Comments:/Conditions:

Comments:/Conditions:

INITIAL SITE SKETCH

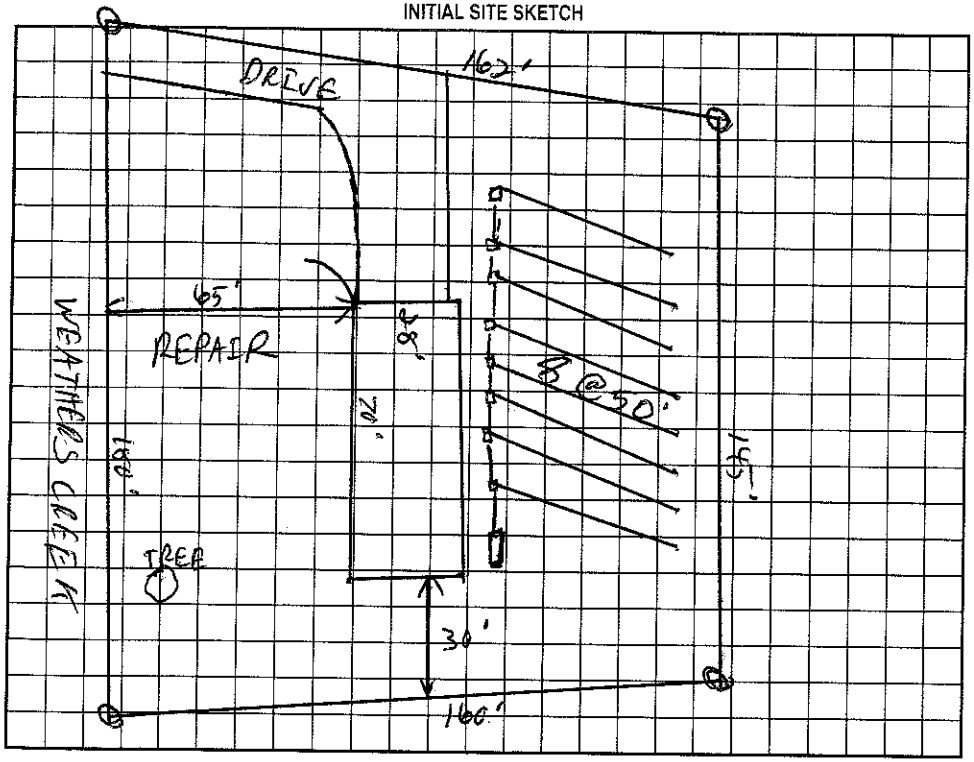

AS BUILT SKETCH

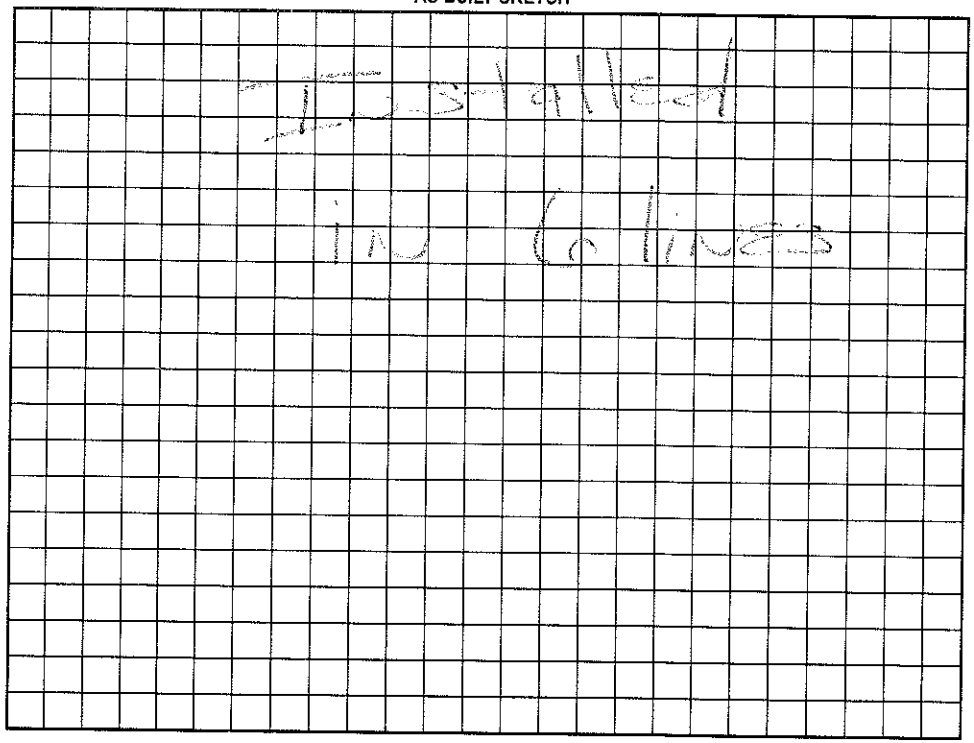

Permit can be suspended or revoked if any false information is supplied toward securing the permit/any unauthorized changes are made to the site/any unauthorized changes are made in the installation of the system. Improvement Permit with plat valid without expiration. Improvement Permit with site plan valid for sixty months. Authorization to Construct is valid for a period equal to that of Improvement Permit – not to exceed sixty months.

Signed: _____ date _____

Improvement Permit by: _____ KS date 8/4/99

Authorization to Construct by: _____ KS date 8/4/99

Installed by: A-1 Backhoe

Operation Permit by: _____ date 1/27/2000

Existing System Inspection by: _____ date _____

HEALTH DEPT. COPY: WHITE OWNER COPY (FINAL): YELLOW OWNER COPY (INITIAL): PINK