# IREDELL COUNTY HEALTH DEPARTMENT

STATESVILLE 704-878-5305 MOORESVILLE 704-664-5281

## IMPROVEMENT PERMIT / AUTHORIZATION TO CONSTRUCT / OPERATION PERMIT / EXISTING SYSTEM INSPECTION

PERMIT# 071355 PIN# ~~4760-15-5234 PT~~ 4760 15 6044 DATE 3/9/98

OWNER OR CONTRACTOR Howard & Associates PHONE: Business 892-3152 Home

ADDRESS 18400 Shearer Rd. Davidson, NC 28036

LOCATION 21 N TR Shinnville Rd TL Weathers Creek Rd TL Sydney

SUBDIVISION Countryview Est. BLOCK / SECTION LOT 2 LOT AREA .56 Acre SITE CLASS. PS DESIGN FLOW 360 gpd L.T.A.R. .3

Septic Tank: 1000 Gallons; STB 744 Date 3/27/98
Pump Tank: Gallons; PT Date
Pump Make: Model Serial No.
Nitrification Field: No Fields 1 Square Feet 1200 Linear Feet 400'
No Lines 6 at 67' Trench Width 36" Max Trench Bottom Depth 30"

[X] New System [ ] Repair System Type: I, [X] II, III, IV, V, VI
System Description: Grav - Conventional
Repair System Description: Same
Maintenance Agreement Required: [ ] Yes [X] No
Gravel Depth 12"

[ ] House/Mod. Home No. Bedrooms 3
[X] Mobile Home No. Bathrooms 2
[ ] Business No. Employees
[ ] Other
[ ] Slab [X] Crawl Space [ ] Basement w/plumbing [ ] Basement wo/plumbing


Water Supply: [X] Individual [ ] Public [ ] Community Multi-Connection

Comments:/Conditions: Septic System should be at least 5' From House & 10' From PL.

Comments:/Conditions: 5@80' INSTALLED AS SHOWN

Scale 1:50

INITIAL SITE SKETCH

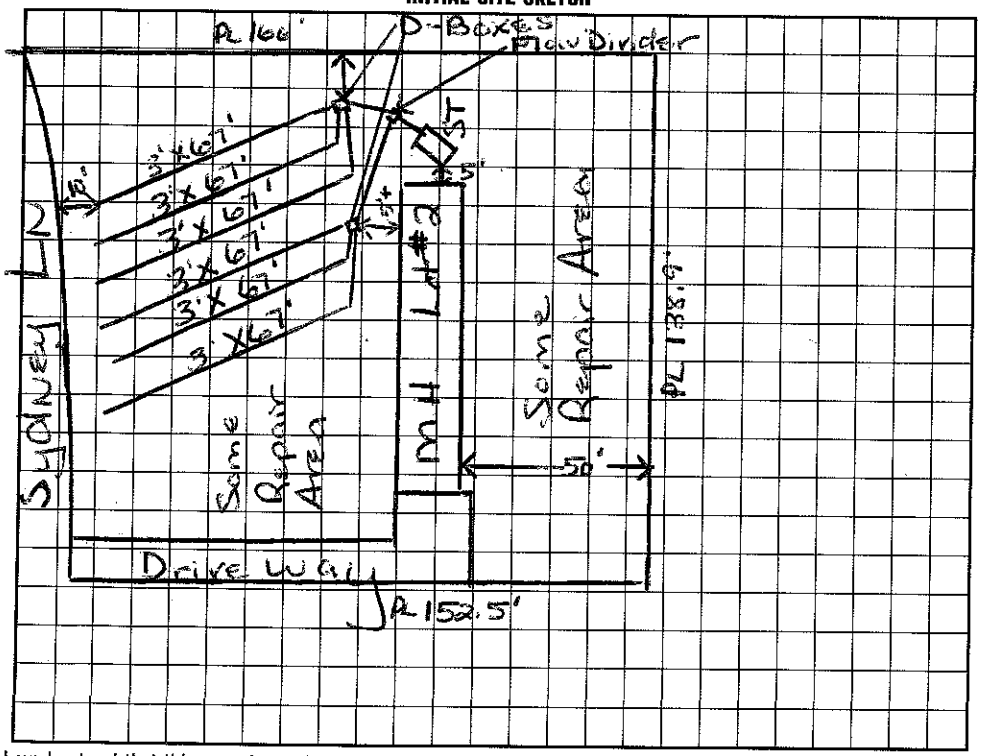


AS BUILT SKETCH

I understand that this permit can be suspended or revoked if any false information is supplied toward securing the permit/any unauthorized changes are made to the site/any unauthorized changes are made in the installation of the system. Improvement Permit with plat valid without expiration. Improvement Permit with site plan valid for sixty months. Authorization to Construct is valid for a period equal to that of Improvement Permit – not to exceed sixty months.

Signed: Ted R. Howard date 3-12-98

Improvement Permit by: Maria H. H. Dotson date 3/9/98

Authorization to Construct by: Maria H. H. Dotson date 3/9/98

Installed by: LARRY BEAM

Operation Permit by: [signature] date 9/16/98

Existing System Inspection by: date

HEALTH DEPT. COPY: WHITE INSPECTION COPY (FINAL): GREEN OWNER COPY (FINAL): YELLOW INSPECTION COPY (INITIAL): PINK OWNER COPY (INITIAL): GOLD