IREDELL COUNTY HEALTH DEPARTMENT

STATESVILLE 704-878-5305 MOORESVILLE 704-664-5281

IMPROVEMENT PERMIT / AUTHORIZATION TO CONSTRUCT / OPERATION PERMIT / EXISTING SYSTEM INSPECTION

PERMIT# 134669 PIN# 4760 152 044 DATE 4/13/06

OWNER OR APPLICANT Wandola Harkey PHONE: Business _____ Home _____

ADDRESS 131 Advantage Ln Mooresville NC 28117

LOCATION 115N, TR Shinnville, TL Weathers Creek, TL Hubbie on Lt.

SUBDIVISION Countryview Est. BLOCK / SECTION _____ LOT 2 LOT AREA 0.56 AC SITE CLASS. PS DESIGN FLOW 360 L.T.A.R. —

Septic Tank: Exist. 1000 Gallons; STB _____ Date _____

Pump Tank: _____ Gallons; PT _____ Date _____

Pump Make: _____ Model _____ Serial No. _____

Nitrification Field: No Fields ____ Square Feet 1200 Linear Feet 400

No Lines 4@100' Trench Width _____ Max Trench Bottom Depth _____ Gravel Depth _____

☐ New System ☐ Repair ☐ Expansion System Type: I (II) III IV V VI

System Description: Conventional

Repair System Description: 25% Reduct.

Maintenance Agreement Required: ☐ Yes ☒ No

☐ House/Mod. Home ☒ Mobile Home ☐ Business ☐ Other

No. Bedrooms 3 No. Persons ____ No. Employees ____


Water Supply: ☐ Individual ☐ Public ☒ Community

☒ Gravity ☐ Pressure ☐ Slab ☒ Crawl Space ☐ Basement w/plumbing ☐ Basement wo/plumbing

Comments:/Conditions:

Comments:/Conditions: Original Permit - 1998

INITIAL SITE SKETCH

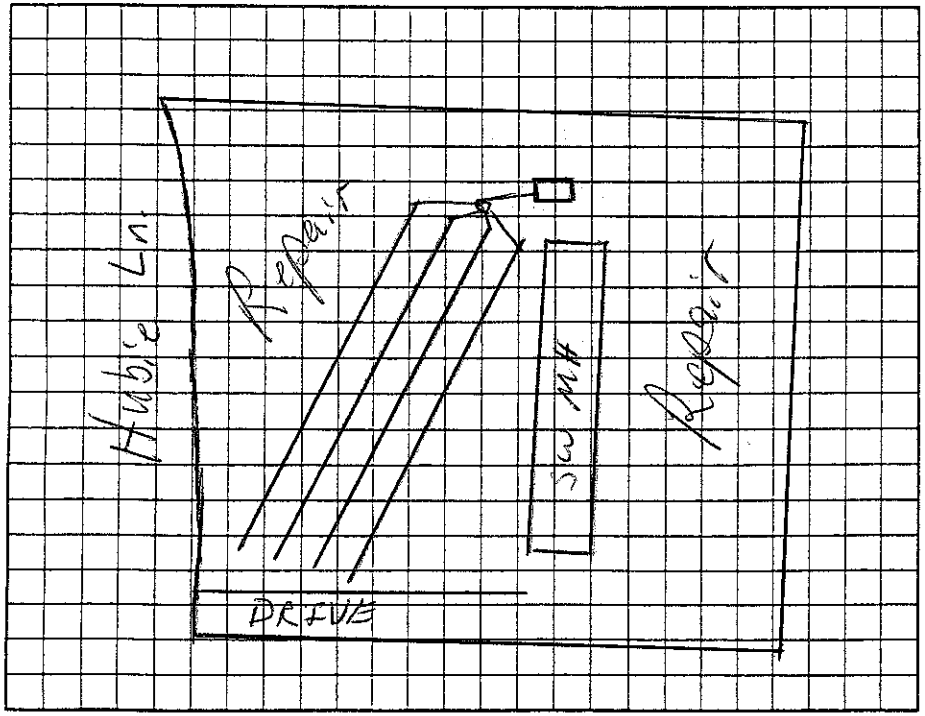

AS BUILT SKETCH

Permit can be suspended or revoked if any false information is supplied toward securing the permit/any unauthorized changes are made to the site/any unauthorized changes are made in the installation of the system. Improvement Permit with plat valid without expiration ☐ Improvement Permit with site plan valid for sixty months ☐ Authorization to Construct is valid for a period equal to that of Improvement Permit – not to exceed sixty months.

Signed: Wandola Harkey date 4-19-06

Installed by: _____

Improvement Permit by: _____ date _____

Operation Permit by: _____ date _____

Authorization to Construct by: _____ date _____

Existing System Inspection by: [signature] RS date 4/13/06

HEALTH DEPT. COPY: WHITE OWNER COPY (FINAL): YELLOW OWNER COPY (INITIAL): PINK