IREDELL COUNTY HEALTH DEPARTMENT

STATESVILLE 704-878-5305 MOORESVILLE 704-664-5281

IMPROVEMENT PERMIT / AUTHORIZATION TO CONSTRUCT / OPERATION PERMIT / EXISTING SYSTEM INSPECTION

PERMIT# 81240 PIN# ~~4760-74058 PT~~ 4760-15-6432 DATE 8/4/99

OWNER OR CONTRACTOR JOEL HOWARD PHONE: Business _____ Home 892-3152

ADDRESS 18400 SHEARERS RD DAVIDSON NC 28036

LOCATION 115 N - TR SHINVILLE RD - TL WEATHERS CREEK - ON LT PAST CREEK

SUBDIVISION COUNTRY VIEW EST. BLOCK / SECTION _____ LOT 10 LOT AREA .63AC SITE CLASS. VS DESIGN FLOW 360 L.T.A.R. .3

Septic Tank: 1600 Gallons; STB 1012 Date 12/15/99
Pump Tank: _____ Gallons; PT _____ Date _____
Pump Make: _____ Model _____ Serial No. _____
Nitrification Field: No Fields 1 Square Feet 1200 Linear Feet 400
No Lines 5 @80 Trench Width 36" Max Trench Bottom Depth 36" Gravel Depth 12"

☑ New System ☐ Repair System Type: I, II, III, IV, V, VI
System Description: GRAVITY CONVENTIONAL
Repair System Description: GRAV/PUMP SAME
Maintenance Agreement Required: ☐ Yes ☑ No

☐ House/Mod. Home ☑ Mobile Home ☐ Business ☐ Other
No. Bedrooms 3 No. Bathrooms 1 No. Employees ____


☐ Slab ☑ Crawl Space ☐ Basement w/plumbing ☐ Basement wo/plumbing

Water Supply: ☐ Individual ☐ Public ☐ ~~Community~~

Comments:/Conditions:

Comments:/Conditions:

INITIAL SITE SKETCH 1"=50'

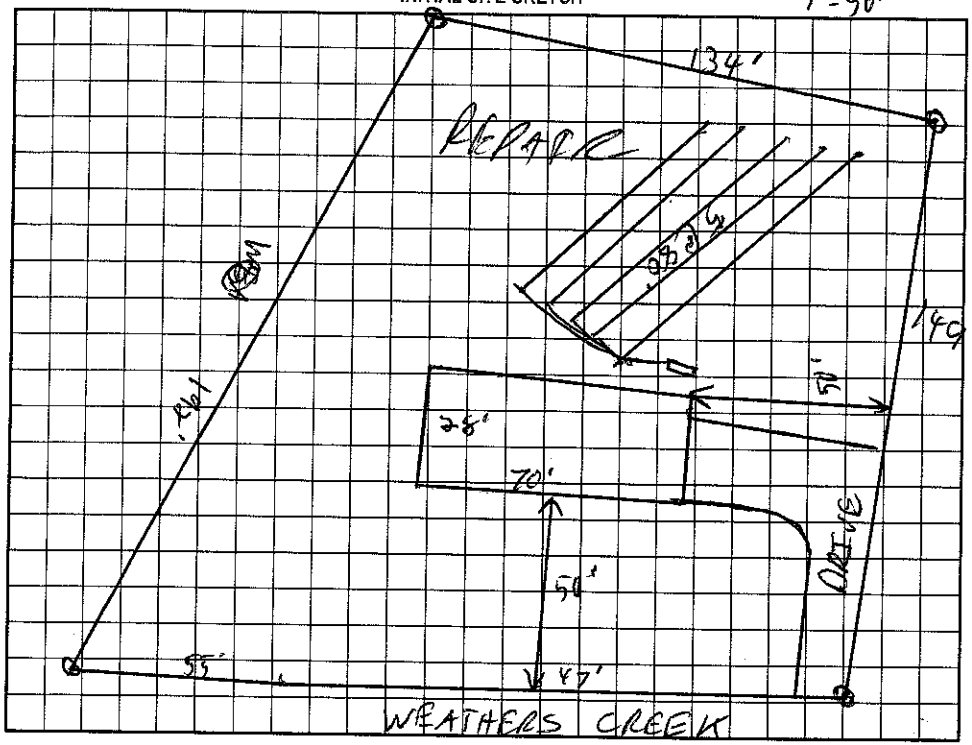

AS BUILT SKETCH

Permit can be suspended or revoked if any false information is supplied toward securing the permit/any unauthorized changes are made to the site/any unauthorized changes are made in the installation of the system. Improvement Permit with plat valid without expiration. Improvement Permit with site plan valid for sixty months. Authorization to Construct is valid for a period equal to that of Improvement Permit – not to exceed sixty months.

Signed: _____ date _____ Installed by: A-1 Back hoe

Improvement Permit by: _____ ES date 8/4/99 Operation Permit by: _____ date 1/27/2000

Authorization to Construct by: _____ ES date 8/4/99 Existing System Inspection by: _____ date _____

HEALTH DEPT. COPY: WHITE OWNER COPY (FINAL): YELLOW OWNER COPY (INITIAL): PINK