IREDELL COUNTY HEALTH DEPARTMENT

STATESVILLE 704-878-5305 MOORESVILLE 704-664-5281

IMPROVEMENT PERMIT / AUTHORIZATION TO CONSTRUCT / OPERATION PERMIT / EXISTING SYSTEM INSPECTION

PERMIT# 071354 PIN# ~~4760175284 PF~~ 4760 15 7077 DATE 2/24/98

OWNER OR CONTRACTOR Howard & Associates PHONE: Business 892-3152 Home

ADDRESS 18400 Shearer Rd Davidson, NC. 28036

LOCATION Hwy 115 N TR Shinnville Rd TL Weathers Creek on corner of Sydney on left

SUBDIVISION Country View Est BLOCK / SECTION LOT 1 LOT AREA .57 Acre SITE CLASS. PS DESIGN FLOW 360gpd L.T.A.R. 0.3

Septic Tank: 1000 Gallons; STB 794 Date 6/5/98

Pump Tank: Gallons; PT Date

Pump Make: Model Serial No.

Nitrification Field: No Fields 1 Square Feet 1200 Linear Feet 400

No Lines Lot 67' Trench Width 36" Max Trench Bottom Depth 36

☐ New System ☐ Repair System Type: I (II) III, IV, V, VI

System Description: Grav. Conventional

Repair System Description: Conventional

Maintenance Agreement Required: ☐ Yes ☒ No

Gravel Depth 12"

☐ House/Mod. Home ☒ Mobile Home ☐ Business ☐ Other

No. Bedrooms 3 No. Bathrooms 2 No. Employees


☐ Slab ☒ Crawl Space ☐ Basement w/plumbing ☐ Basement wo/plumbing

Water Supply: ☒ Individual ☐ Public ☐ Community Multi-Connect.

Comments:/Conditions: Keep Septic System at least 5' from House. & 10' from property lines

Comments:/Conditions:
118
115
116

INITIAL SITE SKETCH Scale 1:50

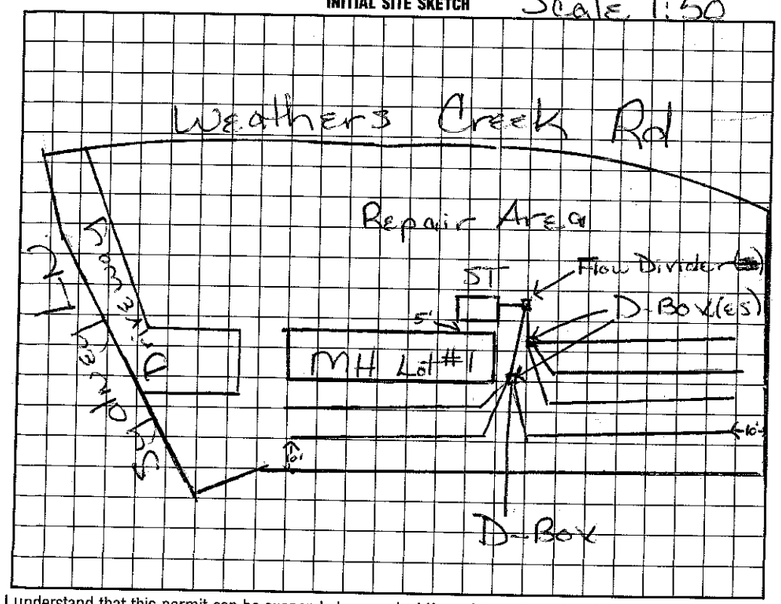

AS BUILT SKETCH

I understand that this permit can be suspended or revoked if any false information is supplied toward securing the permit/any unauthorized changes are made to the site/any unauthorized changes are made in the installation of the system. Improvement Permit with plat valid without expiration. Improvement Permit with site plan valid for sixty months. Authorization to Construct is valid for a period equal to that of Improvement Permit – not to exceed sixty months.

Signed: Joel R. Howard date 3-12-98

Improvement Permit by: Marina Hill Dotson date 3/9/98

Authorization to Construct by: Marina Hill Dotson date 3/9/98

Installed by: LARRY BEAM

Operation Permit by: date 9/17/98

Existing System Inspection by: date

HEALTH DEPT. COPY: WHITE INSPECTION COPY (FINAL): GREEN OWNER COPY (FINAL): YELLOW INSPECTION COPY (INITIAL): PINK OWNER COPY (INITIAL): GOLD