# IREDELL COUNTY HEALTH DEPARTMENT

STATESVILLE 704-878-5305 MOORESVILLE 704-664-5281

## IMPROVEMENT PERMIT / AUTHORIZATION TO CONSTRUCT / OPERATION PERMIT / EXISTING SYSTEM INSPECTION

PERMIT# 093845 PIN# 4760 15 7077 DATE 1/5/01

OWNER OR CONTRACTOR Joel R Howard PHONE: Business 878-6750 Home

ADDRESS 103 Hutchinson Trail Mooresville, NC 28115

LOCATION Shumpalle TL Weathers Creek TL Hubie (2) corner lot

SUBDIVISION County Line Estates BLOCK / SECTION LOT 1 LOT AREA .44ac SITE CLASS. DESIGN FLOW 360 L.T.A.R.

Septic Tank: 1000 EXISTING Gallons; STB Date

Pump Tank: Gallons; PT Date

Pump Make: Model Serial No.

Nitrification Field: No Fields 1 Square Feet Linear Feet 400

No Lines 6 Trench Width EXISTING SYSTEM Max Trench Bottom Depth Gravel Depth

☐ New System ☐ Repair System Type: I (II) III, IV, V, VI

System Description:

Repair System Description: EXISTING SYSTEM

Maintenance Agreement Required: ☐ Yes ☒ No

☐ House/Mod. Home No. Bedrooms 3

☒ Mobile Home No. Bathrooms 2

☐ Business No. Employees

☐ Other

☐ Slab ☐ Crawl Space ☐ Basement w/plumbing ☐ Basement wo/plumbing


Water Supply:
☐ Individual
☐ Public
☒ Community

Comments:/Conditions:

Comments:/Conditions: GRAVEL ROAD

INITIAL SITE SKETCH

AS BUILT SKETCH

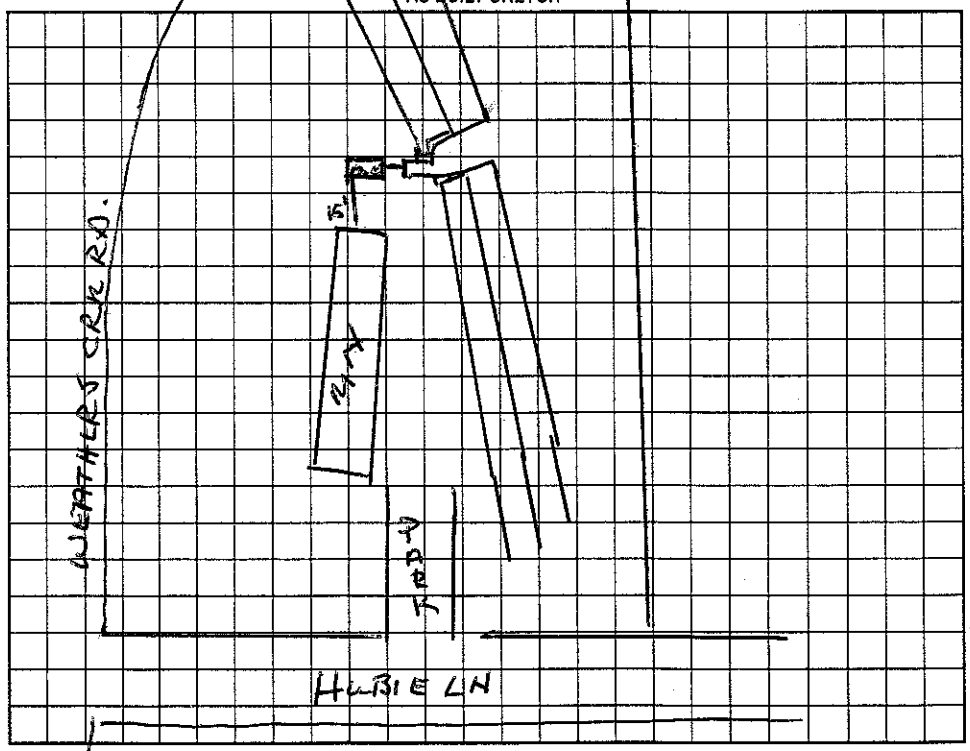


Permit can be suspended or revoked if any false information is supplied toward securing the permit/any unauthorized changes are made to the site/any unauthorized changes are made in the installation of the system. Improvement Permit with plat valid without expiration. Improvement Permit with site plan valid for sixty months. Authorization to Construct is valid for a period equal to that of Improvement Permit – not to exceed sixty months.

Signed: date

Improvement Permit by: date

Authorization to Construct by: date

Installed by:

Operation Permit by: date

Existing System Inspection by: Wesley Sparks R.S. date 1/5/01

HEALTH DEPT. COPY: WHITE OWNER COPY (FINAL): YELLOW OWNER COPY (INITIAL): PINK