IREDELL COUNTY HEALTH DEPARTMENT

Statesville Office (704) 878-5305 Mooresville Office (704) 660-3625 PERMIT # 221193

IMPROVEMENT PERMIT / AUTHORIZATION TO CONSTRUCT / OPERATION PERMIT / EXISTING SYSTEM

PIN # 4760164329 v. 489

APPLICANT: Bobby Davis APPLICANT ADDRESS: 159 Davis Trail Ln Troutman, NC 28166

SITE ADDRESS: 489 Weathers Creek Troutman, NC PHONE: ALT. PHONE: 704 433-3097

SITE DIRECTIONS: US21/Hwy 115 N TR Shinnville Rd TL Weathers Creek on right

SUBDIVISION: Bobby Davis SECTION: — LOT # LOT AREA: 5.3 Acre DESIGN FLOW: 360gpd L.T.A.R.: —

Septic Tank 1000 (gal) STB Date
Pump Tank (gal) PT Date
Pump Make Model Serial #
Nitrification Fields 1 # Lines 2 Linear Ft: 250'
Trench Width Max. Trench Bottom Depth: Existing Gravel Depth

☐ New System ☐ Repair ☐ Expansion System Type: I (II) III IV V VI
System Description: Existing Gravity Conventional
Repair System Description:
Maintenance Agreement Required: ☐ YES ☒ NO
☒ GRAVITY ☐ PRESSURE


☒ Residence No. Bedrooms 3
☐ Business No. Persons 6
☐ Other No. Employees
☐ Slab ☒ Crawl Space
☐ Basement w/ plumbing ☐ Basement w/o plumbing

Water Supply: ☐ Private ☐ Public ☒ Community


Comments / Conditions: Existing Septic System "appears" to be functioning ok at time of inspection Keep new MH at least 10ft from Septic System.

Note: Multiple MH's on this parcel, this permit is just for #489

INITIAL SITE SKETCH

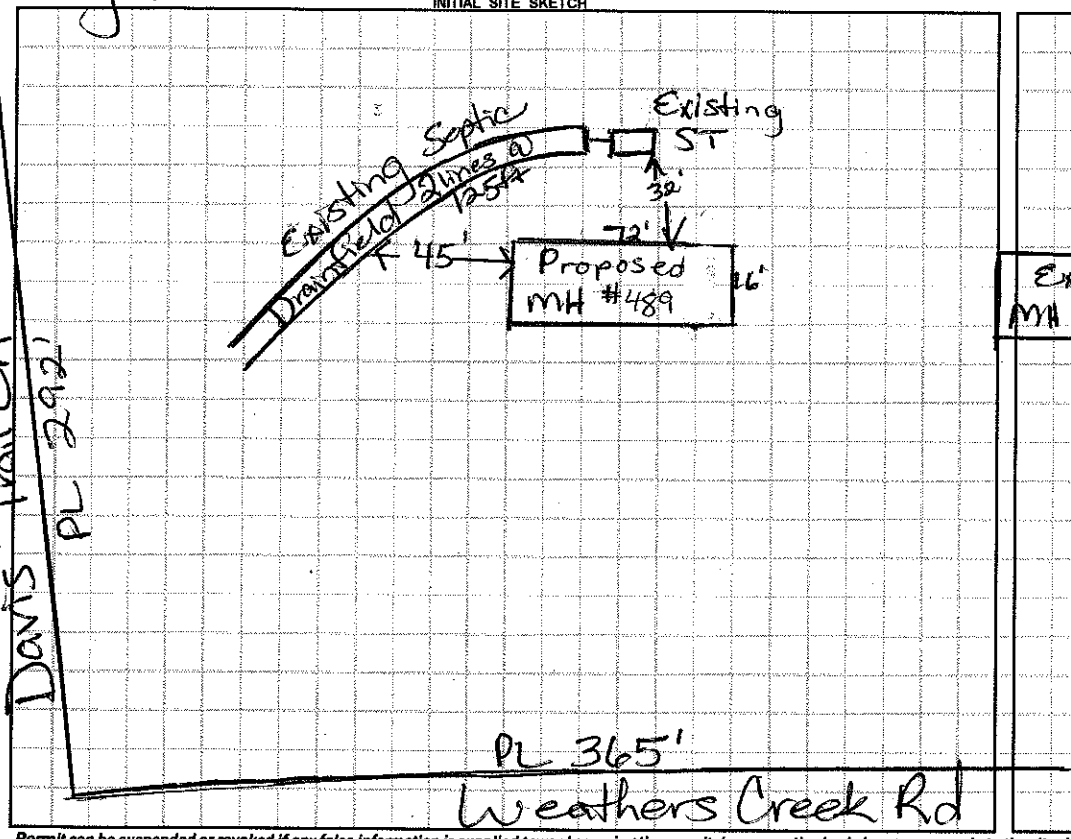

AS BUILT SKETCH

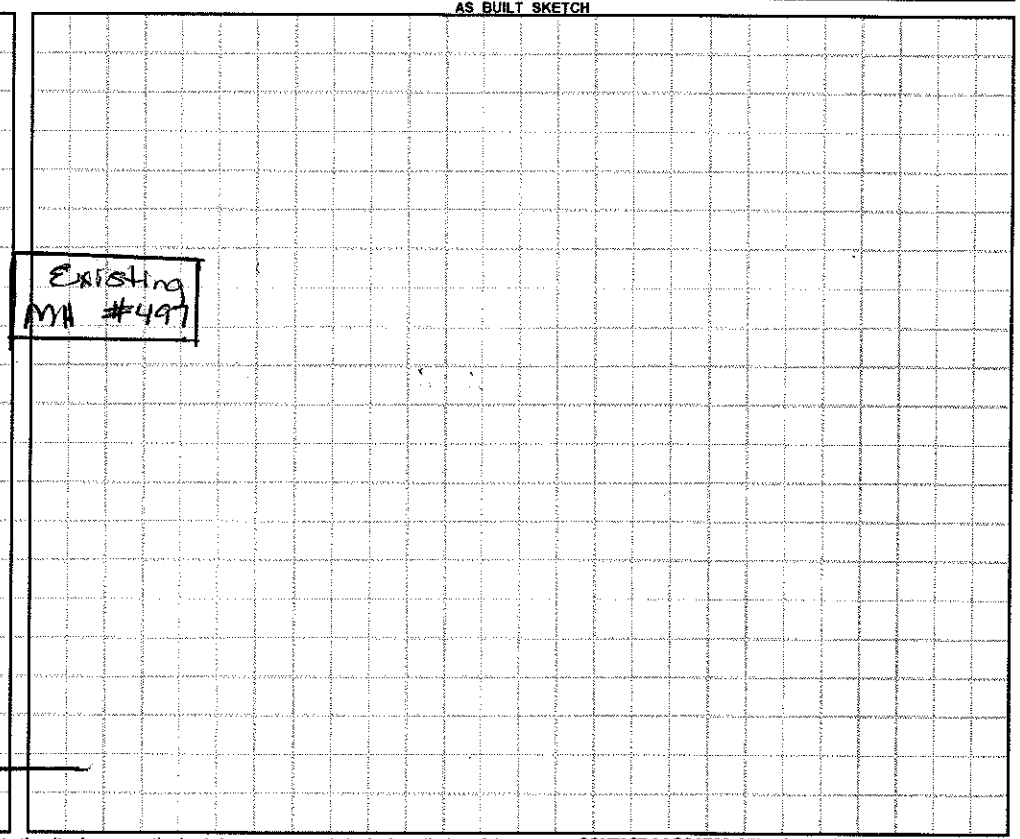

Permit can be suspended or revoked if any false information is supplied toward securing the permit / any unauthorized changes are made to the site / any unauthorized changes are made in the installation of the system. **CONTACT A LOCATOR SERVICE PRIOR TO ANY EXCAVATION**

☐ **IMPROVEMENT PERMIT** *with plat valid without expiration.* ☐ **IMPROVEMENT PERMIT** *with site plan valid for 60 mos.* ☐ **AUTHORIZATION TO CONSTRUCT** *valid for period equal to IMPROVEMENT PERMIT--not to exceed 60 mo.*

Owner / Applicant Signature: Bobby Davis Date: 9-29-16 Installed by:

IMPROVEMENT PERMIT by: Date: OPERATION PERMIT by: Date:

AUTHORIZATION TO CONSTRUCT by: Date: Existing System Inspected by: Maria Dotson RS. Date: 9/27/16

Health Dept. Copy - WHITE Applicant (Final Approval) - YELLOW Applicant (Conditional Approval) - PINK