# IREDELL COUNTY HEALTH DEPARTMENT

STATESVILLE 704-878-5305 MOORESVILLE 704-664-5281

## IMPROVEMENT PERMIT / AUTHORIZATION TO CONSTRUCT / OPERATION PERMIT / EXISTING SYSTEM INSPECTION

PERMIT# 082040 PIN# 4760187738 DATE 5/24/200

OWNER OR CONTRACTOR Herbert Harris PHONE: Business 528-4974 Home

ADDRESS 170 Hanaford Rd Troutman, NC 28166

LOCATION Oswalt Amity Rd TR Weathers Creek TL Hanford to end straight on dirt road house

SUBDIVISION BLOCK / SECTION LOT LOT AREA 1.01 acre SITE CLASS. PS DESIGN FLOW 480 L.T.A.R. .3-.35

Septic Tank: 1000 Gallons; STB 726 Date 3/24/00

Pump Tank: Gallons; PT Date

Pump Make: Model Serial No.

Nitrification Field: No Fields 1 Square Feet 1440 Linear Feet 480

No Lines 4 Trench Width 36" Max Trench Bottom Depth 36" Gravel Depth 12"

☒ New System ☐ Repair System Type: I, II, III, IV, V, VI

System Description: Gravity Conventional

Repair System Description: Innovative

Maintenance Agreement Required: ☐ Yes ☒ No

☒ House/Mod. Home No. Bedrooms 4

☐ Mobile Home No. Bathrooms 3

☐ Business No. Employees

☐ Other


☐ Slab ☒ Crawl Space ☐ Basement w/plumbing ☐ Basement wo/plumbing

Water Supply: ☒ Individual ☐ Public ☐ Community

Comments:/Conditions:

PL 436

INITIAL SITE SKETCH

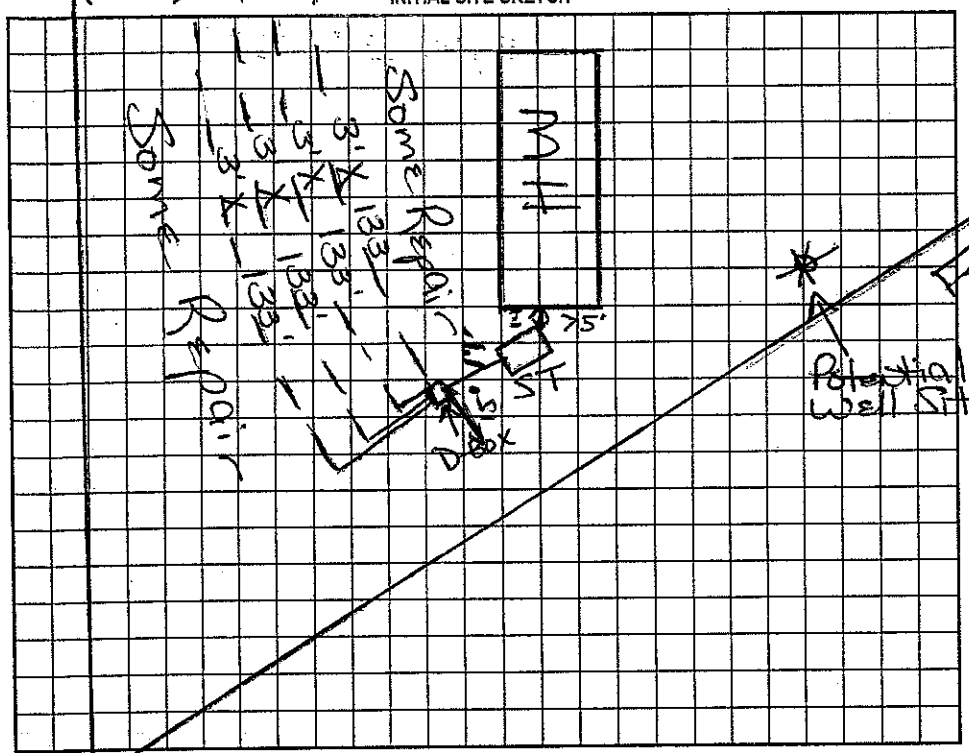


Comments:/Conditions:

*Well not installed at time of inspec

AS BUILT SKETCH

Permit can be suspended or revoked if any false information is supplied toward securing the permit/any unauthorized changes are made to the site/any unauthorized changes are made in the installation of the system. Improvement Permit with plat valid without expiration. Improvement Permit with site plan valid for sixty months. Authorization to Construct is valid for a period equal to that of Improvement Permit – not to exceed sixty months.

Signed: date

Improvement Permit by: date

Authorization to Construct by: date

Installed by: Larry Reep

Operation Permit by: Maiwa H. Dotson RS date 5/25/20

Existing System Inspection by: date

HEALTH DEPT. COPY: WHITE OWNER COPY (FINAL): YELLOW OWNER COPY (INITIAL): PINK