IREDELL COUNTY HEALTH DEPARTMENT

Statesville Office (704) 878-5305 Mooresville Office (704) 660-3625 PERMIT # 210849

IMPROVEMENT PERMIT / AUTHORIZATION TO CONSTRUCT / OPERATION PERMIT (EXISTING SYSTEM)

PIN # 4760 18 4738

APPLICANT: SCOTT BRETTIN - MELISSA ELLIS APPLICANT ADDRESS: 162 REBEKAH LANE TROUTMAN, NC. 28166

SITE ADDRESS: SAME PHONE: 704-746-4361 ALT. PHONE: NONE

SITE DIRECTIONS: Oswalt Rd TR ~~Hanford~~ TL TR Hanford TL Rebekah to last house


SUBDIVISION: N/A SECTION: LOT #: LOT AREA: DESIGN FLOW: L.T.A.R.:

Septic Tank	1000	(gal)	STB		Date		☐ New System	☐ Repair	☐ Expansion	System Type: I (II) III IV V VI	☑ Residence	No. Bedrooms	4	Water Supply	
Pump Tank		(gal)	PT		Date		System Description: GRAVITY - GRAVEL				☐ Business	No. Persons		☑ Private	
Pump Make			Model		Serial #		Repair System Description:				☐ Other	No. Employees		☐ Public	
# Nitrification Fields	4		# Lines		Linear Ft:	480	Maintenance Agreement Required:	☐ YES	☐ NO		☐ Slab	☐ Crawl Space		☐ Community	
Trench Width			Max. Trench Bottom Depth		Gravel Depth			☐ GRAVITY	☐ PRESSURE		☐ Basement w/plumbing			☐ Basement w/o plumbing	


Comments / Conditions:

POOL LOCATION MEETS MINIMUM SETBACKS.
NO EVIDENCE OF SYSTEM MALFUNCTION SEEN.

INITIAL SITE SKETCH

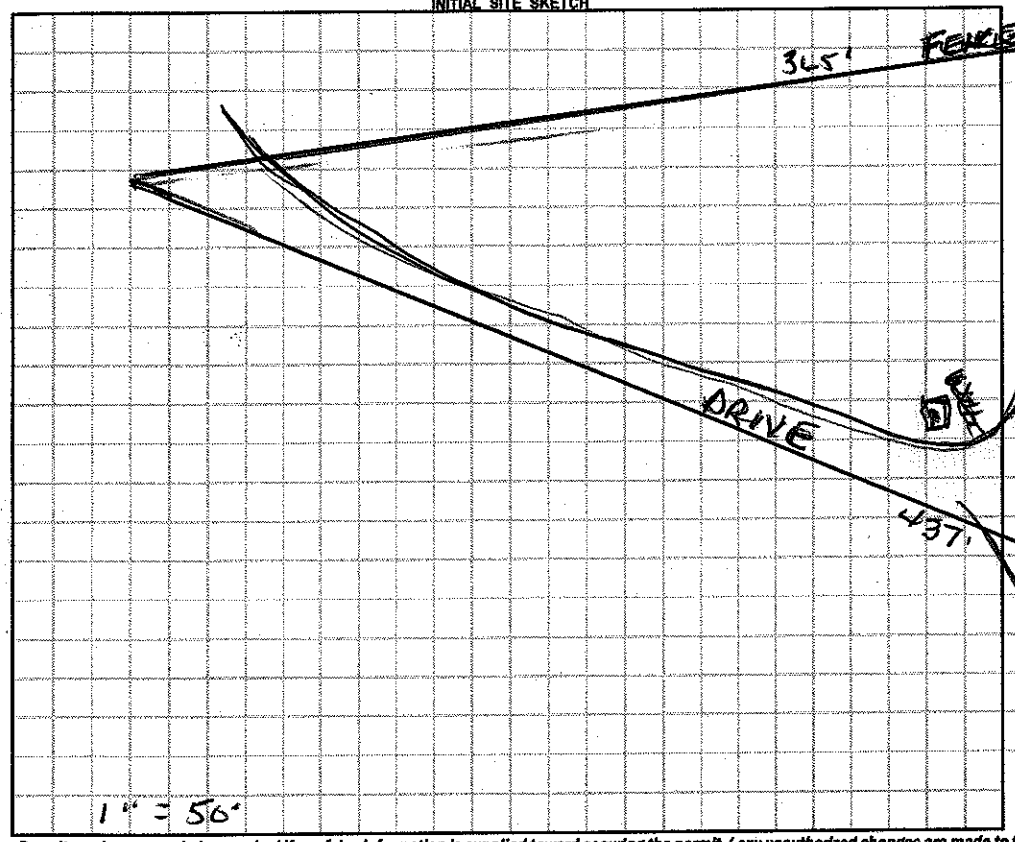

AS BUILT SKETCH

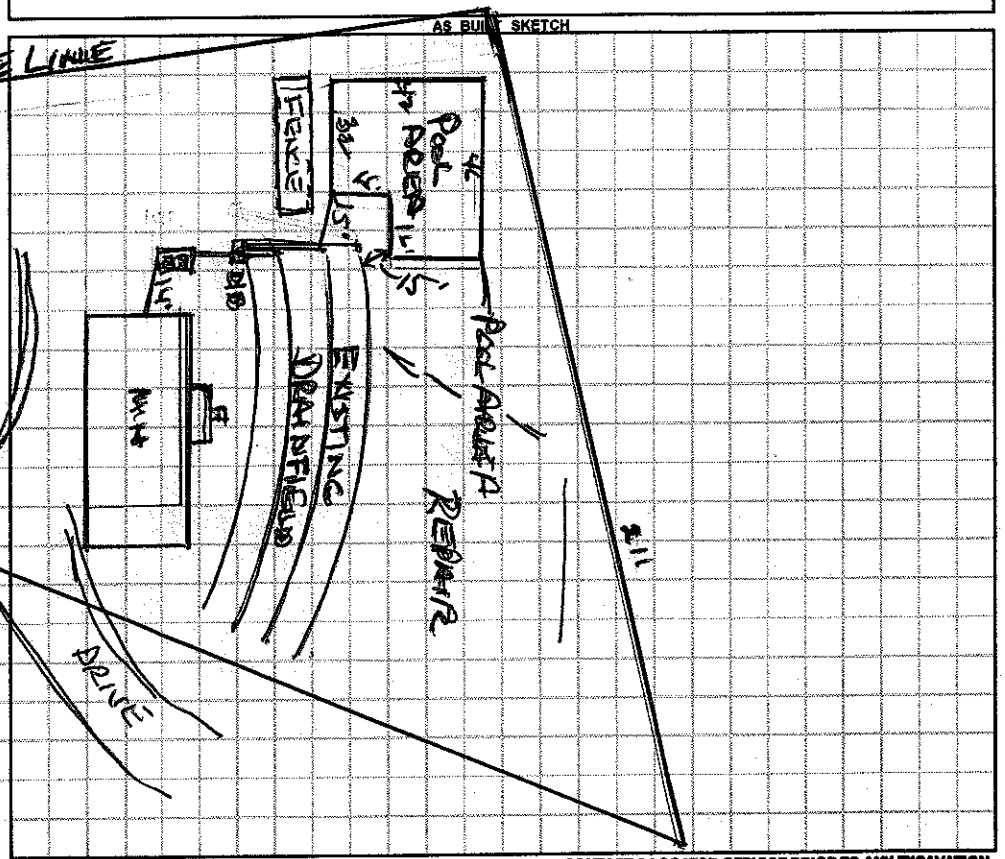

Permit can be suspended or revoked if any false information is supplied toward securing the permit / any unauthorized changes are made to the site / any unauthorized changes are made in the installation of the system. **CONTACT A LOCATOR SERVICE PRIOR TO ANY EXCAVATION**

☐ **IMPROVEMENT PERMIT** *with plat valid without expiration.* ☐ **IMPROVEMENT PERMIT** *with site plan valid for 60 mos.* ☐ **AUTHORIZATION TO CONSTRUCT** *valid for period equal to IMPROVEMENT PERMIT--not to exceed 60 mo.*

Owner / Applicant Signature: Melissa Ellis Date: 6/17/15 Installed by:

IMPROVEMENT PERMIT by: Date: OPERATION PERMIT by: Date:

AUTHORIZATION TO CONSTRUCT by: Date: Existing System Inspected by: Wesley Sparks Date: 6/12/2015

Health Dept. Copy - WHITE Applicant (Final Approval) - YELLOW Applicant (Conditional Approval) - PINK