# IREDELL COUNTY HEALTH DEPARTMENT

STATESVILLE 704-878-5305 MOORESVILLE 704-664-5281

## IMPROVEMENT PERMIT / AUTHORIZATION TO CONSTRUCT / OPERATION PERMIT / EXISTING SYSTEM INSPECTION

PERMIT# 079352 PIN# 4760194356 DATE 3/23/99

OWNER OR CONTRACTOR Larry Brandon PHONE: Business _____ Home 528-9405

ADDRESS 172 Hanford RD.

LOCATION Shiloville TL Weathers Creek RT Hanford RD Last trailer on Rt

SUBDIVISION — BLOCK / SECTION — LOT — LOT AREA 4.65 SITE CLASS. PS DESIGN FLOW 240 L.T.A.R. .3

Septic Tank: 1000 Gallons; STB _____ Date _____

Pump Tank: _____ Gallons; PT _____ Date _____

Pump Make: _____ Model Existing Serial No. _____

Nitrification Field: No Fields 1 Square Feet _____ Linear Feet _____

No Lines _____ Trench Width _____ Max Trench Bottom Depth _____ Gravel Depth _____

☐ New System ☐ Repair System Type: I, (II) III, IV, V, VI

System Description: Existing

Repair System Description: _____

Maintenance Agreement Required: ☐ Yes ☐ No

☑ House/Mod. Home No. Bedrooms 3 2

☐ Mobile Home No. Bathrooms 2

☐ Business No. Employees _____

☐ Other _____


☐ Slab ☑ Crawl Space ☐ Basement w/plumbing ☐ Basement wo/plumbing

Water Supply: ☑ Individual ☐ Public ☐ Community

Comments:/Conditions: System functioning properly at time of inspection. Drain lines to deep to find.

Comments:/Conditions:

INITIAL SITE SKETCH (Not to Scale)

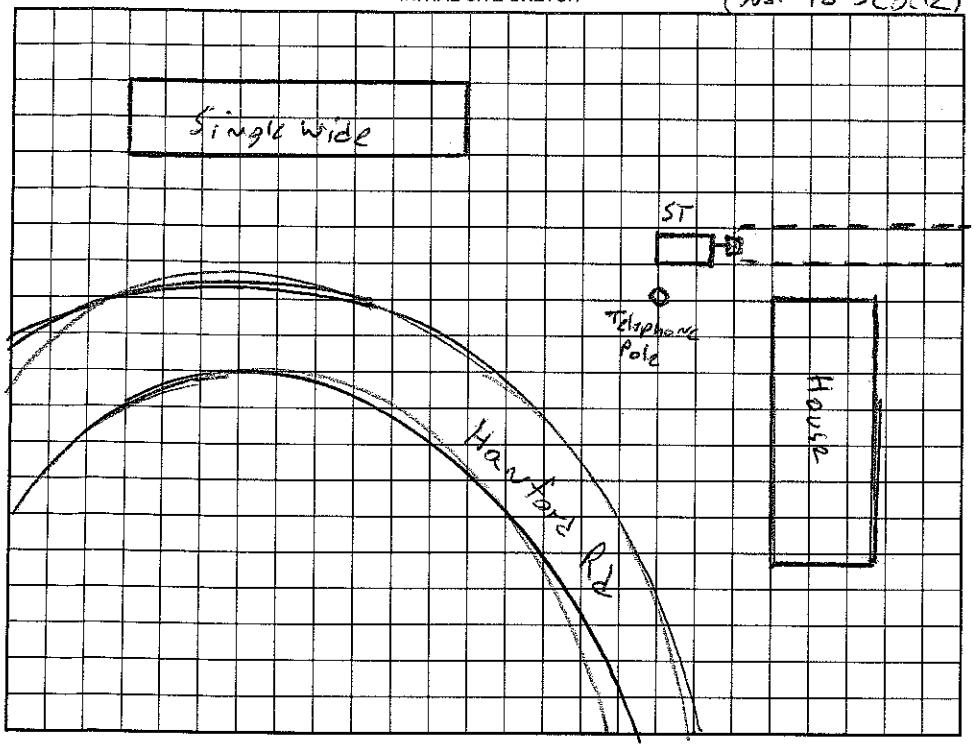


AS BUILT SKETCH

Permit can be suspended or revoked if any false information is supplied toward securing the permit/any unauthorized changes are made to the site/any unauthorized changes are made in the installation of the system. Improvement Permit with plat valid without expiration. Improvement Permit with site plan valid for sixty months. Authorization to Construct is valid for a period equal to that of Improvement Permit – not to exceed sixty months.

Signed: Larry Brandon date 4-6-99

Improvement Permit by: _____ date _____

Authorization to Construct by: _____ date _____

Installed by: _____

Operation Permit by: _____ date _____

Existing System Inspection by: Jeff Mayan date 3/23/99

HEALTH DEPT. COPY: WHITE OWNER COPY (FINAL): YELLOW OWNER COPY (INITIAL): PINK