IREDELL COUNTY HEALTH DEPARTMENT

Authorization to Construct (4.00) 4760194796

STATESVILLE 704-878-5305 MOORESVILLE 704-664-5281

IMPROVEMENT PERMIT / ~~CERTIFICATE OF COMPLETION~~ / OPERATION PERMIT / EXISTING SYSTEM INSPECTION

PROPERTY DESCRIPTION NO. 24323 DATE 8/27/96 TAX MAP NO. 4K A 22 Pt of.

OWNER OR CONTRACTOR Mary Morrison PHONE: Business _____ Home _____ Watershed: ☐ Yes ☒ No

ADDRESS 135 Richy Rd. Mooresville, NC.

LOCATION Williams Creek Rd. TR Hanford Rd. 2ND MH on (L)

SUBDIVISION NO BLOCK / SECTION ___ LOT ___ LOT AREA acreage SITE CLASS. PS DESIGN FLOW 360 L.T.A.R. .3

Septic Tank: 1000 Gallons; STB 1012 Date 9-3-96

Pump Tank: _____ Gallons; PT _____ Date _____

Pump Make: _____ Model _____ Serial No. _____

Nitrification Field: No Fields 4 Square Feet 1200 Linear Feet 400

No Lines 4 Trench Width 36" Max Trench Bottom Depth 36" Gravel Depth 12"

☒ New System ☐ Repair System Type: I (II) III, IV, V, VI

System Description: CONV - DIST BOX

Repair System Description: _____

Maintenance Agreement Required: ☐ Yes ☐ No

☐ Slab ☒ Crawl Space ☐ Basement w/plumbing ☐ Basement wo/plumbing

☐ House/Mod. Home No. Bedrooms 3

☒ Mobile Home No. Bathrooms 2

☐ Business No. Employees ___


☐ Other _____

Water Supply: ☒ Individual ☐ Community ☐ Public

Comments:

1" = 40'


INITIAL SITE SKETCH

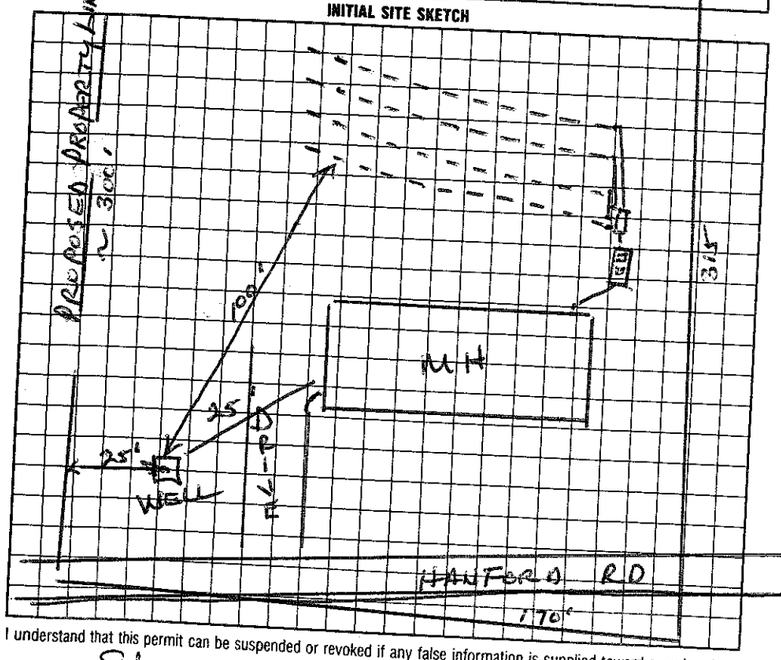

Comments:

WELL CHANGED TO 60' FROM SEPTIC SYSTEM. APPROVED 10/30/96 - CBF

AS BUILT SKETCH

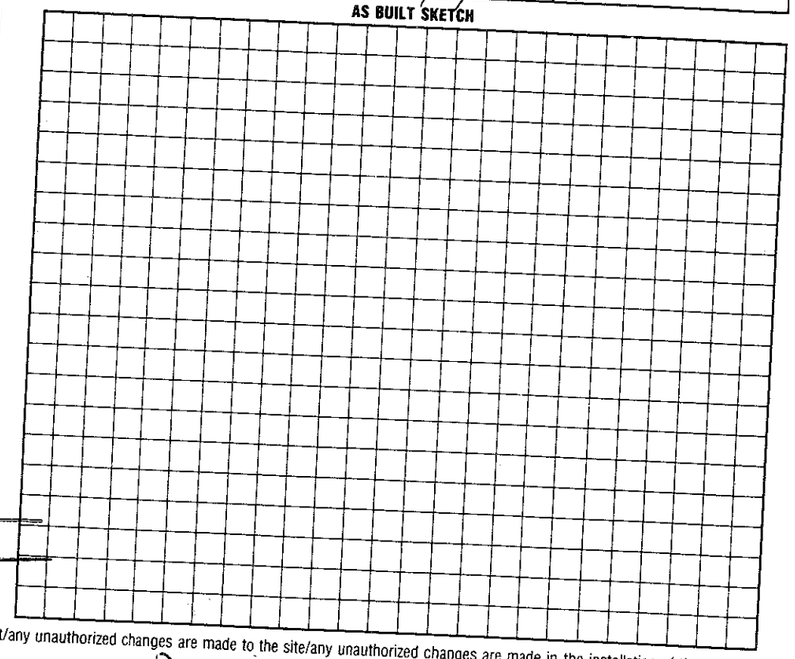

I understand that this permit can be suspended or revoked if any false information is supplied toward securing the permit/any unauthorized changes are made to the site/any unauthorized changes are made in the installation of the system.

Signed: *Sharon Goad

Improvement Permit by: Wesley Sparks RS. date 8/27/96

~~Existing System Inspection by:~~ Wesley Sparks RS date 8/27/96

Installed by: Dennis Gulick

Certificate of Completion by: _____ date _____

Operation Permit by: Wesley Sparks RS. date 12/30/96

HEALTH DEPT. COPY: WHITE INSPECTION COPY (FINAL): GREEN OWNER COPY (FINAL): YELLOW INSPECTION COPY (INITIAL): PINK OWNER COPY (INITIAL): GOLD