IREDELL COUNTY HEALTH DEPARTMENT

Statesville Office (704) 878-5305 Mooresville Office (704) 660-3625 PERMIT # 206488

IMPROVEMENT PERMIT / AUTHORIZATION TO CONSTRUCT / OPERATION PERMIT / EXISTING SYSTEM

PIN # 4760-25-4782-3973.

APPLICANT: Margaret Carpenter APPLICANT ADDRESS: 105 Burgess Cir Mooresville

SITE ADDRESS: 141 Buckin Ln PHONE: ALT. PHONE:

SITE DIRECTIONS: Hwy 115 N, TR on Shinnville Rd, TL on Westers Crk, Property on R, Access in middle of Sugar Crk Lp

SUBDIVISION: Hildebrand Family SECTION: LOT # 1 LOT AREA: 2.553 ac DESIGN FLOW: 360 gpd L.T.A.R.: 0.3

Septic Tank	1000 (gal)	STB ~~760~~	Date 2/18	☑ New System	☐ Repair	☐ Expansion	System Type: I II ⓘ IV V VI	☑ Residence	No. Bedrooms 3	Water Supply
Pump Tank	(gal)	PT	Date	System Description: Gravity 25% Reduction				☐ Business	No. Persons 6	☑ ~~Private~~
Pump Make	Model		Serial #	Repair System Description: LPP PBBPS				☐ Other	No. Employees	☐ Public
# Nitrification Fields 1	# Lines 2 (CF)		Linear Ft: 300	Maintenance Agreement Required:	☐ YES	☒ NO		☐ Slab	☑ Crawl Space	☐ Community
Trench Width 36"	Max. Trench Bottom Depth 36"		Gravel Depth N/A	☒ GRAVITY	☐ PRESSURE			☐ Basement w/plumbing	☐ Basement w/o plumbing	

Comments / Conditions: - DO NOT ISSUE AC UNTIL PLAT IS RECORDED - *Plat Recorded See Attached

INITIAL SITE SKETCH

SEE DESIGN BY S & ME

(Dated 10-20-14, Approved 10-30-14 AZP)

AS BUILT SKETCH

INSTALLED AS DRAWN.

ARC 34 CHAMBERS

Permit can be suspended or revoked if any false information is supplied toward securing the permit / any unauthorized changes are made to the site / any unauthorized changes are made in the installation of the system. **CONTACT A LOCATOR SERVICE PRIOR TO ANY EXCAVATION**


☐ **IMPROVEMENT PERMIT** *with plat valid without expiration.* ☑ **IMPROVEMENT PERMIT** *with site plan valid for 60 mos.* ☑ **AUTHORIZATION TO CONSTRUCT** *valid for period equal to IMPROVEMENT PERMIT--not to exceed 60 mo.*

Owner / Applicant Signature: Teena Alee Date: 11/3/14 Installed by: Tim Hosee

IMPROVEMENT PERMIT by: Date: 10-30-14 OPERATION PERMIT by: APPROVED MAY 18 2015 Date:

AUTHORIZATION TO CONSTRUCT by: Date: 3-26-15 Existing System Inspected by: Date:

Health Dept. Copy - WHITE Applicant (Final Approval) - YELLOW Applicant (Conditional Approval) - PINK

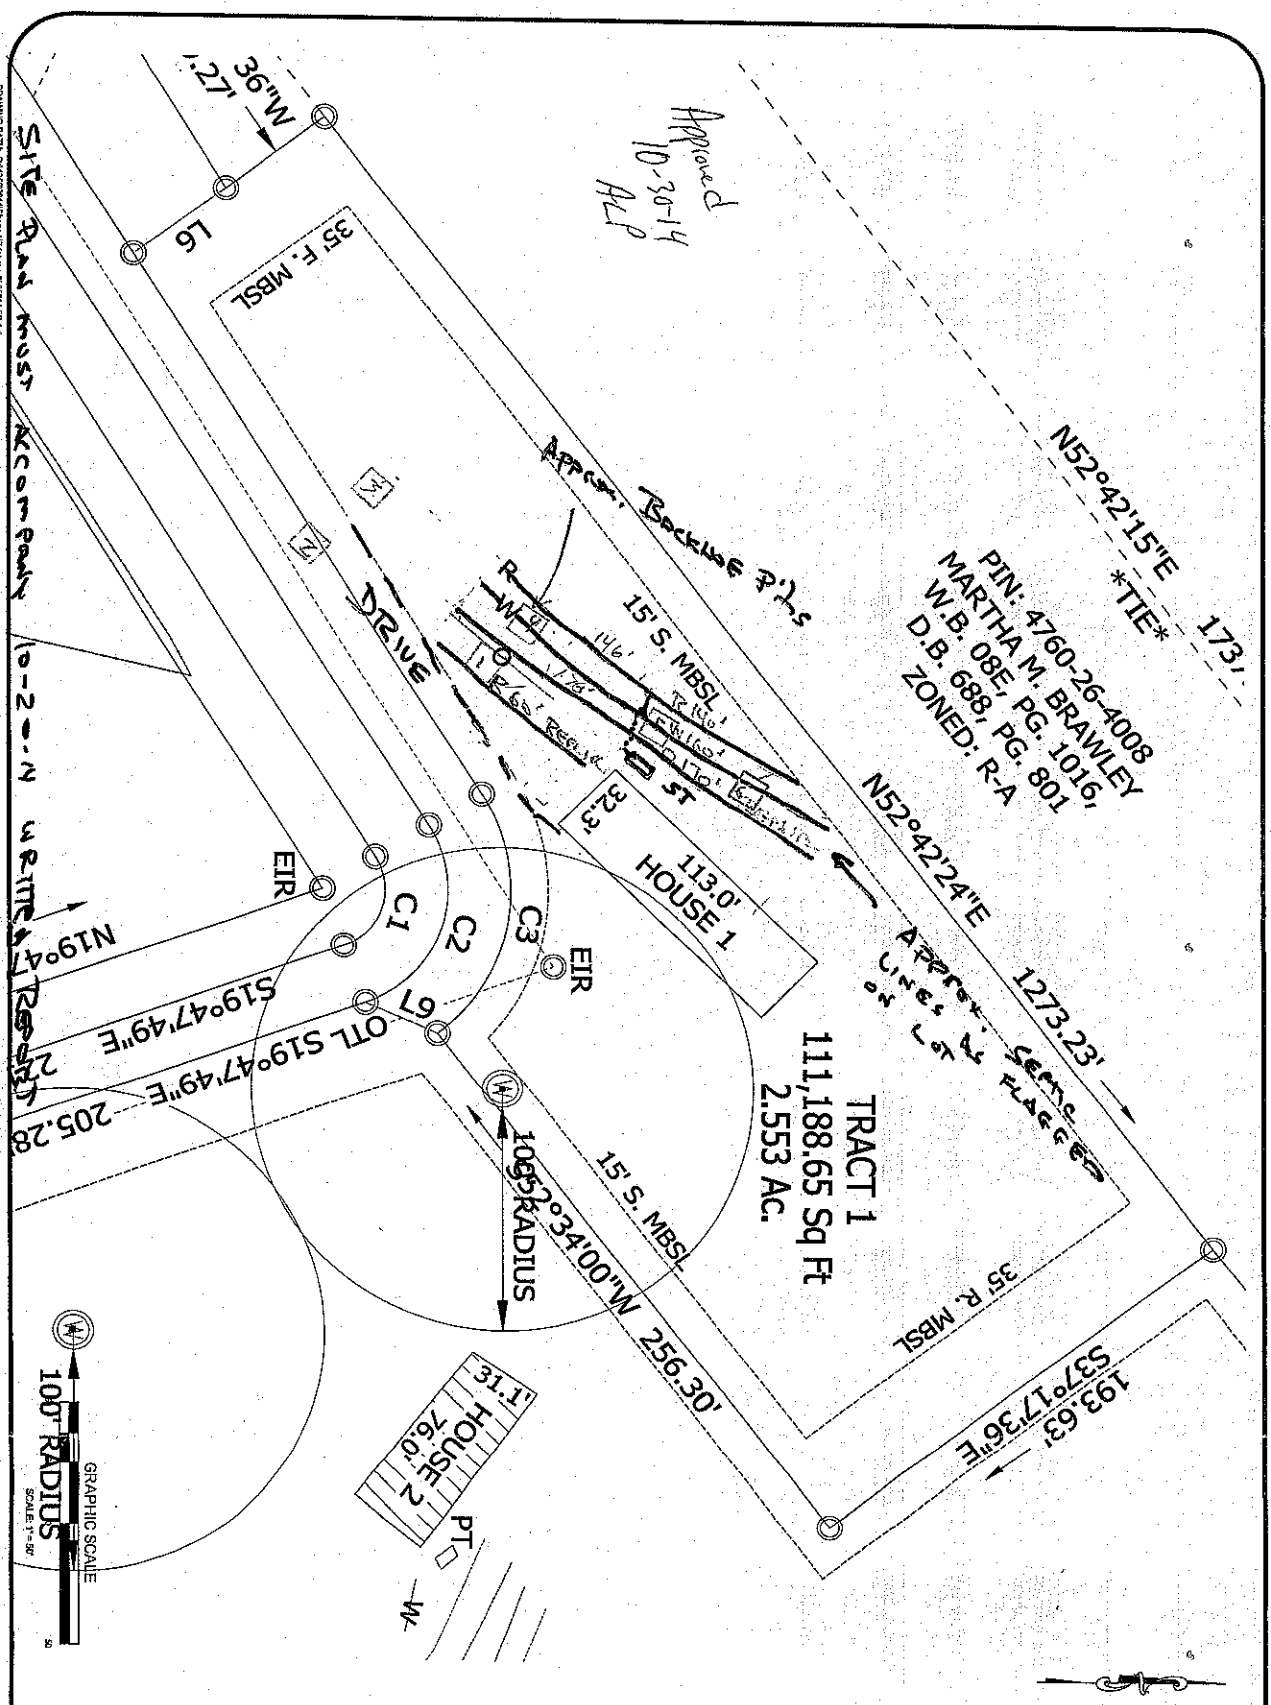

S&ME

3718 OLD BATTLEGROUND ROAD
GREENSBORO, NC. 27410
PH. 336-288-7160
FAX. 336-288-8980
WWW.SMEINC.COM

TRACT 1 SITE PLAN
CLAYTON HOMES #72
HILDEBRAND FAMILY SUBDIVISION
IREDELL COUNTY, NORTH CAROLINA

SCALE: AS SHOWN	DRAWN BY: RDM	CHECKED BY: PP
JOB NO. 4358-14-101	DATE: OCTOBER 2014	FIGURE NO. 1