IREDELL COUNTY HEALTH DEPARTMENT

STATESVILLE 704-878-5305 MOORESVILLE 704-664-5281

IMPROVEMENT PERMIT / AUTHORIZATION TO CONSTRUCT / OPERATION PERMIT / EXISTING SYSTEM INSPECTION

PERMIT# 087041 PIN# ~~4760 35 7435 PtOF~~ 4760 25 6192 DATE 1/27/00

OWNER OR CONTRACTOR Shea Parlier PHONE: Business 872-5878 Home

ADDRESS 939 Radio Rd. Statesville, NC. 28677

LOCATION Shinnville Rd, TL Weathers Creek TR first gravel road past church, end of road on (L)

SUBDIVISION No BLOCK / SECTION LOT LOT AREA 1.0 SITE CLASS. PS DESIGN FLOW 360 L.T.A.R. .3

Septic Tank: 1000 Gallons; STB 1012 Date 6/7/00
Pump Tank: Gallons; PT Date
Pump Make: Model Serial No.
Nitrification Field: No Fields 1 Square Feet * 900 Linear Feet * 300
No Lines 3 Trench Width 36" Max Trench Bottom Depth 36" Gravel Depth SAND

☑ New System ☐ Repair System Type: I, II, (III), IV, V, VI
System Description: * HDS OR CHAM PLAS.
Repair System Description: SAME
Maintenance Agreement Required: ☐ Yes ☐ No

☒ House/Mod. Home No. Bedrooms 3
☐ Mobile Home No. Bathrooms 2
☐ Business No. Employees
☐ Other


☐ Slab ☒ Crawl Space ☐ Basement w/plumbing ☐ Basement wo/plumbing

Water Supply: ☒ Individual ☐ Public ☐ Community

Comments:/Conditions: * HDS OR CHAM PLASTIC

Comments:/Conditions: No well on site 9/6/00

12¢ INITIAL SITE SKETCH (1" = 50')

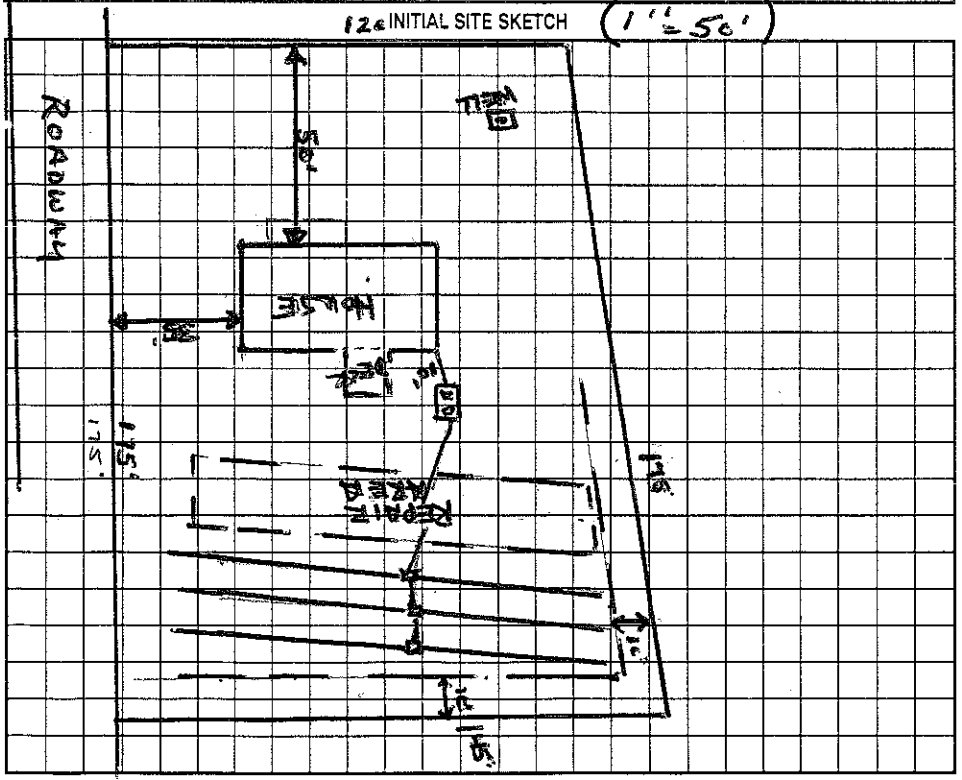

AS BUILT SKETCH

Permit can be suspended or revoked if any false information is supplied toward securing the permit/any unauthorized changes are made to the site/any unauthorized changes are made in the installation of the system. Improvement Permit with plat valid without expiration. Improvement Permit with site plan valid for sixty months. Authorization to Construct is valid for a period equal to that of Improvement Permit – not to exceed sixty months.

Signed: * Teresa Brawley date 1-28-00 Installed by: A-1 Backhoe

Improvement Permit by: Wesley Sparks RS. date 1/27/00 Operation Permit by: Wesley Sparks RS date 9/6/00

Authorization to Construct by: Wesley Sparks RS. date 1/27/00 Existing System Inspection by: date

HEALTH DEPT. COPY: WHITE OWNER COPY (FINAL): YELLOW OWNER COPY (INITIAL): PINK