EDELL COUNTY HEALTH DEPARTMENT

Authorization to Construct

STATESVILLE 704-878-5305 MOORESVILLE 704-664-5281

IMPROVEMENT PERMIT / ~~CERTIFICATE OF COMPLETION~~ / OPERATION PERMIT / EXISTING SYSTEM INSPECTION

PROPERTY DESCRIPTION NO. 23257 DATE 3/15/96 TAX MAP NO. 4G H 50 pt of Watershed: ☐ Yes ☑ No

OWNER OR CONTRACTOR Bobby Davis ~~PHONE: Business~~ PIN#4760-27-1308 Home 528-9978

ADDRESS 459 Weathers Creek Troutman NC

LOCATION Shinville - TL Weathers Creek - TL Davis Trail - end of cul-de-sac

SUBDIVISION Bobby Davis BLOCK / SECTION — LOT 4 LOT AREA 4.013 ac SITE CLASS PS DESIGN FLOW 360gpd T.A.R. .39 gpd/sf

Septic Tank: 1000 Gallons; STB [illegible] Date 2/20/96

Pump Tank: _____ Gallons; PT _____ Date _____

Pump Make: _____ Model _____ Serial No. _____

Nitrification Field: No Fields 1 Square Feet 1200 Linear Feet 400

No Lines 4 Trench Width 36" Max Trench Bottom Depth 36" Gravel Depth 12"

☑ New System ☐ Repair System Type: I II III IV V VI

System Description: Gravity Conventional

Repair System Description: Same

Maintenance Agreement Required: ☐ Yes ☐ No

☐ House/Mod. Home No. Bedrooms 3

☑ Mobile Home No. Bathrooms 2

☐ Business No. Employees ____

☐ Other ____


☐ Slab ☑ Crawl Space ☐ Basement w/plumbing ☐ Basement wo/plumbing

Water Supply: ☑ Individual ☐ Community ☐ Public

Comments:

Comments:

INITIAL SITE SKETCH

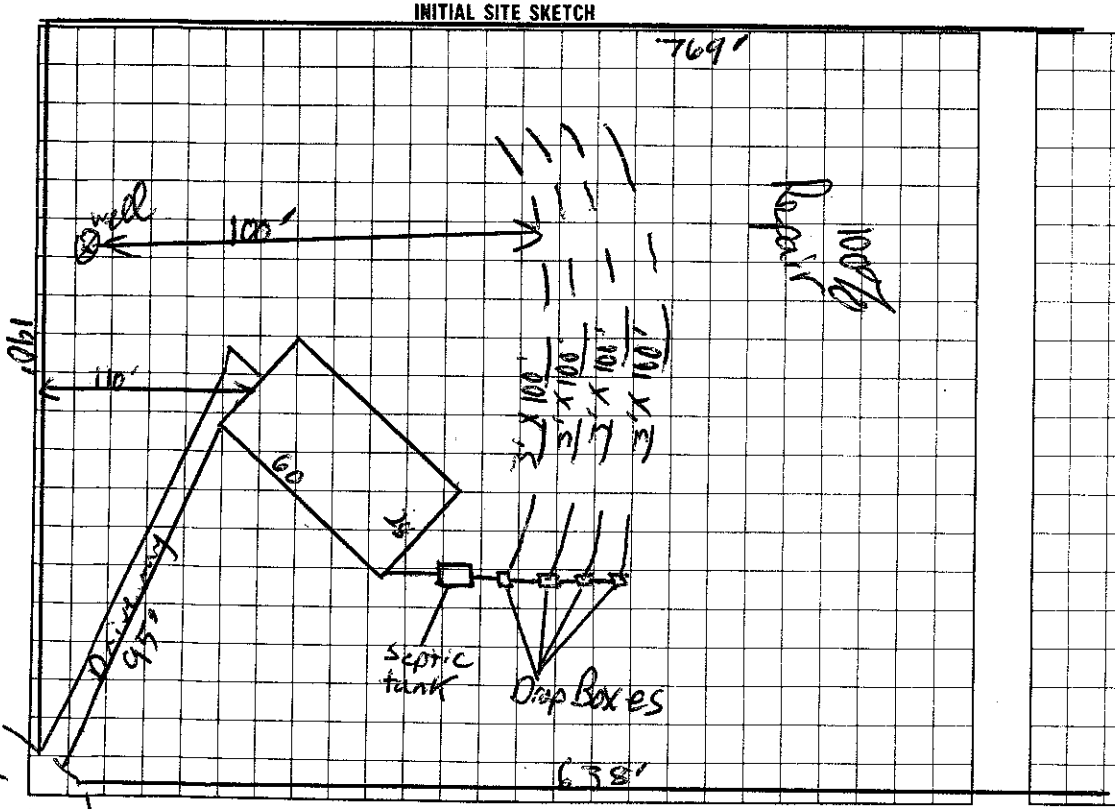

AS BUILT SKETCH

I understand that this permit can be suspended or revoked if any false information is supplied toward securing the permit/any unauthorized changes are made to the site/any unauthorized changes are made in the installation of the system.

Signed: Bobby Davis

Installed by: Donald Lackey

Improvement Permit by: C. Bobby Freeman EHSD date 3/15/96

Authorization to Construct

~~Existing System Inspection by:~~ C. Bobby Freeman EHSD date 3/15/96

Certificate of Completion by: _____ date _____

Operation Permit by: Wesley Sparks RS date 4/24/96

HEALTH DEPT. COPY: WHITE INSPECTION COPY (FINAL): GREEN OWNER COPY (FINAL): YELLOW INSPECTION COPY (INITIAL): PINK OWNER COPY (INITIAL): GOLD