10:30

DELL COUNTY HEALTH DEPARTMENT

STATESVILLE 704-878-5305 MOORESVILLE 704-664-5281

ROVEMENT PERMIT / AUTHORIZATION TO CONSTRUCT / OPERATION PERMIT / EXISTING SYSTEM INSPECTION

T# 073318 PIN# 4760272187 DATE May 22, '98

I OR CONTRACTOR Bobby G. Davis PHONE: Business Home

SS 159 Davis Trail Lane Trentman

ON Ostwalt Amity TR Weathers Creek TL Davis Trail AT End on Right

'ISION B. Davis Property BLOCK / SECTION LOT 5 LOT AREA ± 4 Acres SITE CLASS. PS DESIGN FLOW 360gpd L.T.A.R. .03

Tank: 1000 Gallons; STB 1012 Date 4/1/98

Tank: Gallons; PT Date

Make: Model Serial No.

ation Field: No Fields 1 Square Feet 1200 Linear Feet 460

es 3@133' Trench Width 36" Max Trench Bottom Depth 36"

☑ New System ☐ Repair System Type: I, II, III, IV, V, VI

System Description: gravity conventional

Repair System Description: Same

Maintenance Agreement Required: ☐ Yes ☑ No

Gravel Depth 12"

☐ House/Mod. Home No. Bedrooms 3

☑ Mobile Home No. Bathrooms 2

☐ Business No. Employees

☐ Other

☐ Slab ☑ Crawl Space ☐ Basement w/plumbing ☐ Basement wo/plumbing

Water Supply: ☐ Individual ☐ Public ☐ Community

WELL ACROSS STREET ± 200'

ents:/Conditions:


Upper LATERAL Flagged in white

Comments:/Conditions:

MH OR WELL NOT LOCATED AT INSPECTION CBT 6/9/98

NOT TO SCALE

INITIAL SITE SKETCH

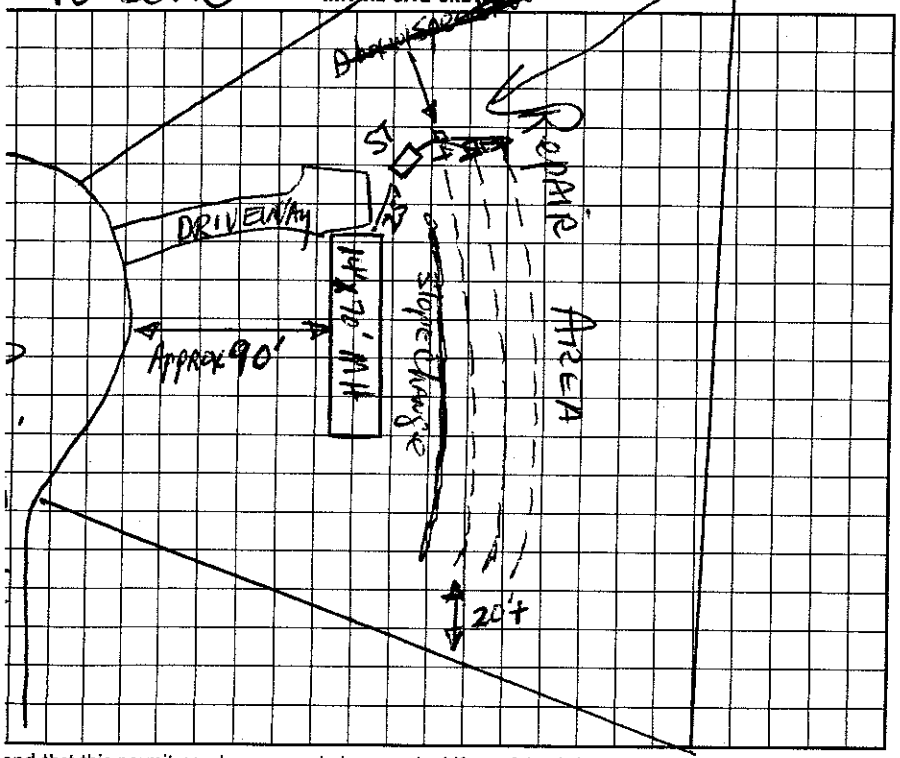

AS BUILT SKETCH

and that this permit can be suspended or revoked if any false information is supplied toward securing the permit/any unauthorized changes are made to the site/any unauthorized changes are made in the installa- e system. Improvement Permit with plat valid without expiration. Improvement Permit with site plan valid for sixty months. Authorization to Construct is valid for a period equal to that of Improvement Permit – not sixty months.

* Bobby Davis date

ent Permit by: date 5-22-98

tion to Construct by: date 5-22-98

Installed by: DONALD JACKEY

Operation Permit by: C. Bailey Trentman date 6/9/98

Existing System Inspection by: date

HEALTH DEPT. COPY: WHITE INSPECTION COPY (FINAL): GREEN OWNER COPY (FINAL): YELLOW INSPECTION COPY (INITIAL): PINK OWNER COPY (INITIAL): GOLD