10.30

IREDELL COUNTY HEALTH DEPARTMENT

STATESVILLE 704-878-5305 MOORESVILLE 704-664-5281

IMPROVEMENT PERMIT / AUTHORIZATION TO CONSTRUCT / OPERATION PERMIT / EXISTING SYSTEM INSPECTION

PERMIT# 073318 PIN# 4760272187 DATE May 22, '98

OWNER OR CONTRACTOR Bobby G. Davis PHONE: Business _____ Home _____

ADDRESS 159 Davis Trail Lane Troutman

LOCATION Ostwalt Amity TR Weathers Creek TL Davis Trail AT End ON Right

SUBDIVISION B. Davis Property BLOCK / SECTION _____ LOT 5 LOT AREA ± 4 Acres SITE CLASS. PS DESIGN FLOW 360 gpd L.T.A.R. .03

Septic Tank: 1000 Gallons; STB 1012 Date 4/1/98
Pump Tank: _____ Gallons; PT _____ Date _____
Pump Make: _____ Model _____ Serial No. _____
Nitrification Field: No Fields 1 Square Feet 1200 Linear Feet 400
No Lines 3@133' Trench Width 36" Max Trench Bottom Depth 36"

☑ New System ☐ Repair System Type: I, II, III, IV, V, VI
System Description: gravity conventional
Repair System Description: _____ & Same
Maintenance Agreement Required: ☐ Yes ☑ No
Gravel Depth 12"

☐ House/Mod. Home No. Bedrooms 3
☑ Mobile Home No. Bathrooms 2
☐ Business No. Employees _____
☐ Other _____
☐ Slab ☑ Crawl Space ☐ Basement w/plumbing ☐ Basement wo/plumbing

Water Supply: ☑ Individual ☐ Public ☐ Community


Ex WELL ACROSS Street > 200'

Comments:/Conditions:
Upper LATERAL Flagged in white

Comments:/Conditions:
MH OR WELL NOT LOCATED AT INSPECTION
CET 6/9/98

Not To Scale

INITIAL SITE SKETCH

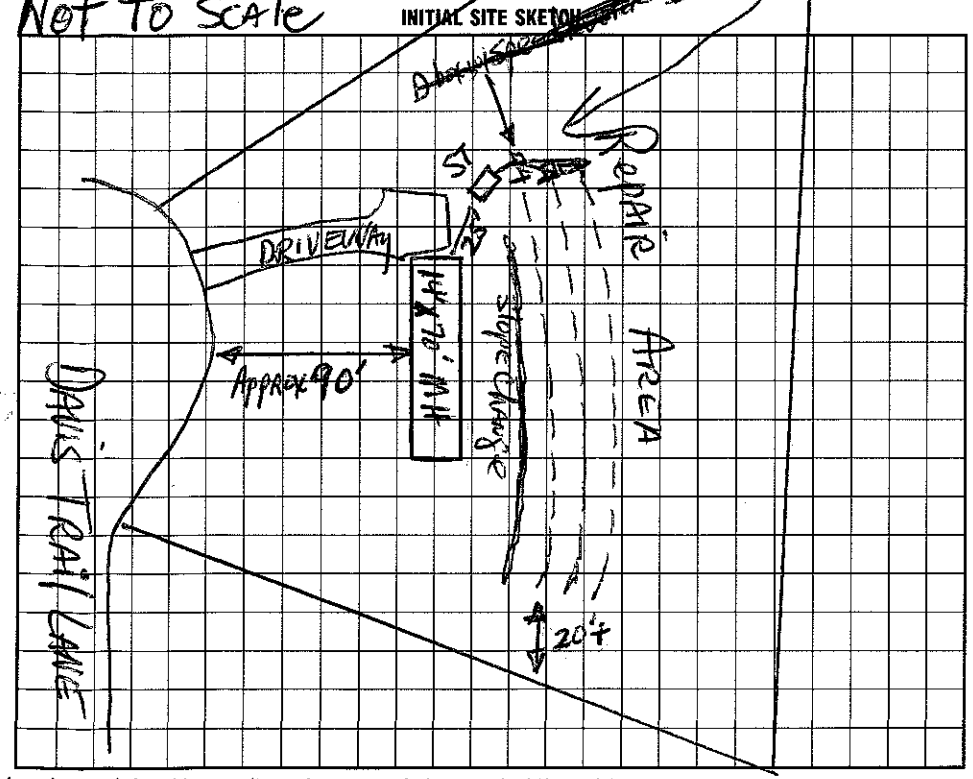

AS BUILT SKETCH

I understand that this permit can be suspended or revoked if any false information is supplied toward securing the permit/any unauthorized changes are made to the site/any unauthorized changes are made in the installation of the system. Improvement Permit with plat valid without expiration. Improvement Permit with site plan valid for sixty months. Authorization to Construct is valid for a period equal to that of Improvement Permit – not to exceed sixty months.

Signed: Bobby Davis date _____
Improvement Permit by: _____, RS date 5-22-98
Authorization to Construct by: _____, RS date 5-22-98

Installed by: DONALD JACKEY
Operation Permit by: _____ date 6/9/98
Existing System Inspection by: _____ date _____

HEALTH DEPT. COPY: WHITE INSPECTION COPY (FINAL): GREEN OWNER COPY (FINAL): YELLOW INSPECTION COPY (INITIAL): PINK OWNER COPY (INITIAL): GOLD