IREDELL COUNTY HEALTH DEPARTMENT

Statesville Office (704) 878-5305 Mooresville Office (704) 660-3625 PERMIT # 206486

IMPROVEMENT PERMIT / AUTHORIZATION TO CONSTRUCT / OPERATION PERMIT / EXISTING SYSTEM

PIN # 4760-35-0354

APPLICANT: Katie Leslie APPLICANT ADDRESS: 149 Buckin Ln Troutman 28166

SITE ADDRESS: 176 Buckin Ln - Troutman PHONE: 704-677-8889 ALT. PHONE:

SITE DIRECTIONS: Hwy 115 N, TR Shinnville, TL Weathers Crk, TR Buckin Ln, Lot @ end


SUBDIVISION: Shane E. Hildebrand Family SECTION: LOT # 4 LOT AREA: 5.162 DESIGN FLOW: 360 gpd L.T.A.R.: 0.3

Septic Tank	1000	(gal)	STB	760	Date	12-21-15	☑ New System	☐ Repair	☐ Expansion	System Type: I II III IV V VI	
Pump Tank		(gal)	PT		Date		System Description:	Gravity 25% Reduction			
Pump Make		Model			Serial #		Repair System Description:	Gravity 25% Reduction			
# Nitrification Fields	1	# Lines	3		Linear Ft:	300'	Maintenance Agreement Required:	☐ YES	☐ NO		
Trench Width	36"	Max. Trench Bottom Depth	24"		Gravel Depth	N/A		☐ GRAVITY	☐ PRESSURE		


☑ Residence	No. Bedrooms	3	Water Supply	
☐ Business	No. Persons	6	☑ Private	
☐ Other	No. Employees		☐ Public	
☐ Slab	☑ Crawl Space		☐ Community	
☐ Basement w/plumbing			☐ Basement w/o plumbing	

Comments / Conditions: Redraw due to 0.162 ac being added to property after well was drilled off property. Property was recorded as 5.00 ac originally on 1-7-15.

INITIAL SITE SKETCH

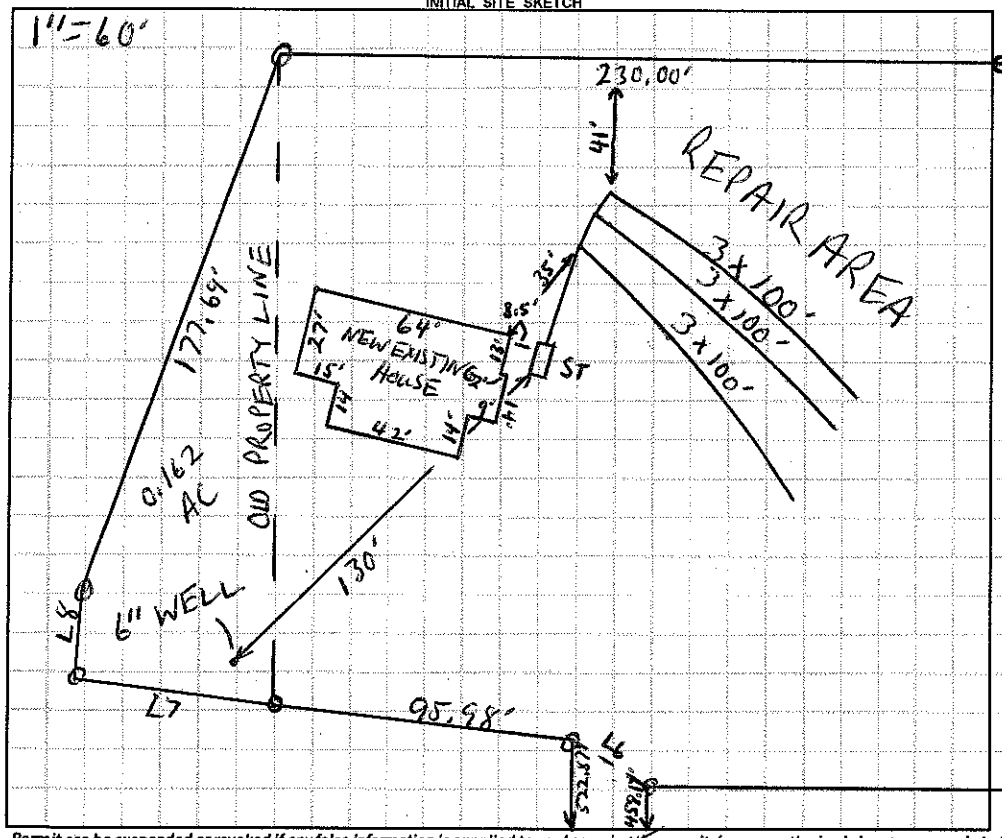

AS BUILT SKETCH

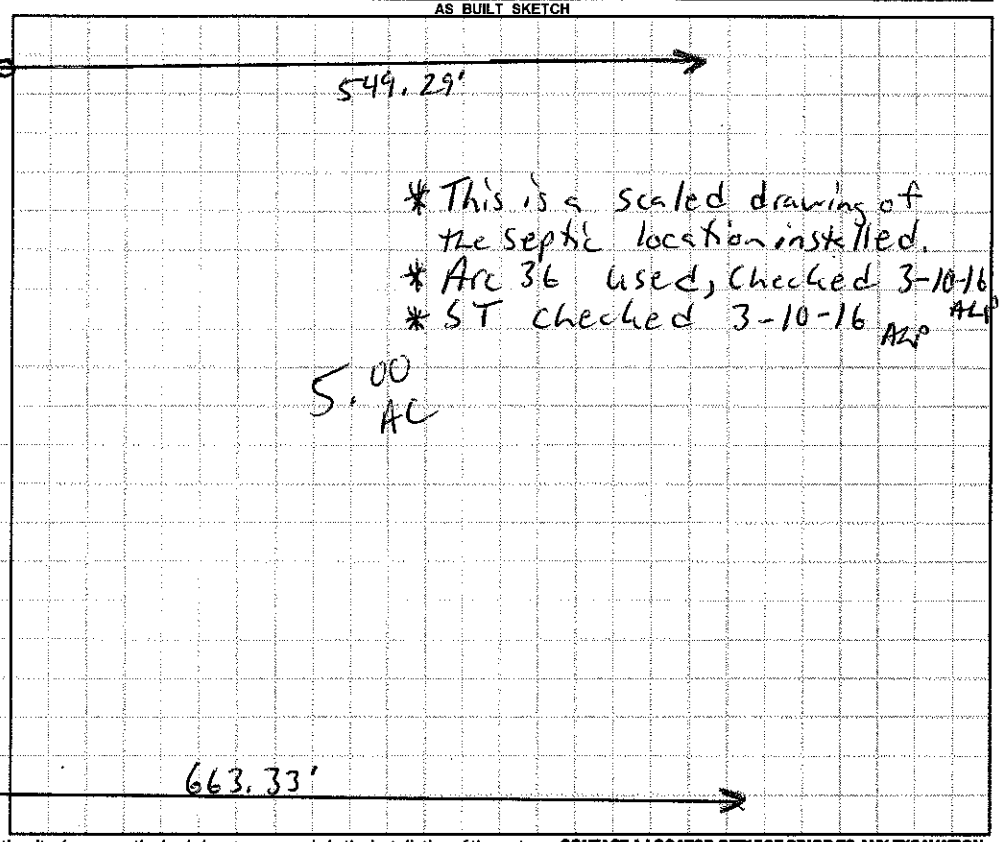

Permit can be suspended or revoked if any false information is supplied toward securing the permit / any unauthorized changes are made to the site / any unauthorized changes are made in the installation of the system. **CONTACT A LOCATOR SERVICE PRIOR TO ANY EXCAVATION**


☐ **IMPROVEMENT PERMIT** *with plat valid without expiration.* ☑ **IMPROVEMENT PERMIT** *with site plan valid for 60 mos.* ☑ **AUTHORIZATION TO CONSTRUCT** *valid for period equal to IMPROVEMENT PERMIT--not to exceed 60 mo.*

Owner / Applicant Signature: Dennal Abee Date: 4/5/16 Installed by: Tim Abee

IMPROVEMENT PERMIT by: [signature] Date: 4-4-16 OPERATION PERMIT by: [signature] Date: 4-5-16

AUTHORIZATION TO CONSTRUCT by: [signature] Date: 4-5-16 Existing System Inspected by: Date:

Health Dept. Copy - WHITE Applicant (Final Approval) - YELLOW Applicant (Conditional Approval) - PINK

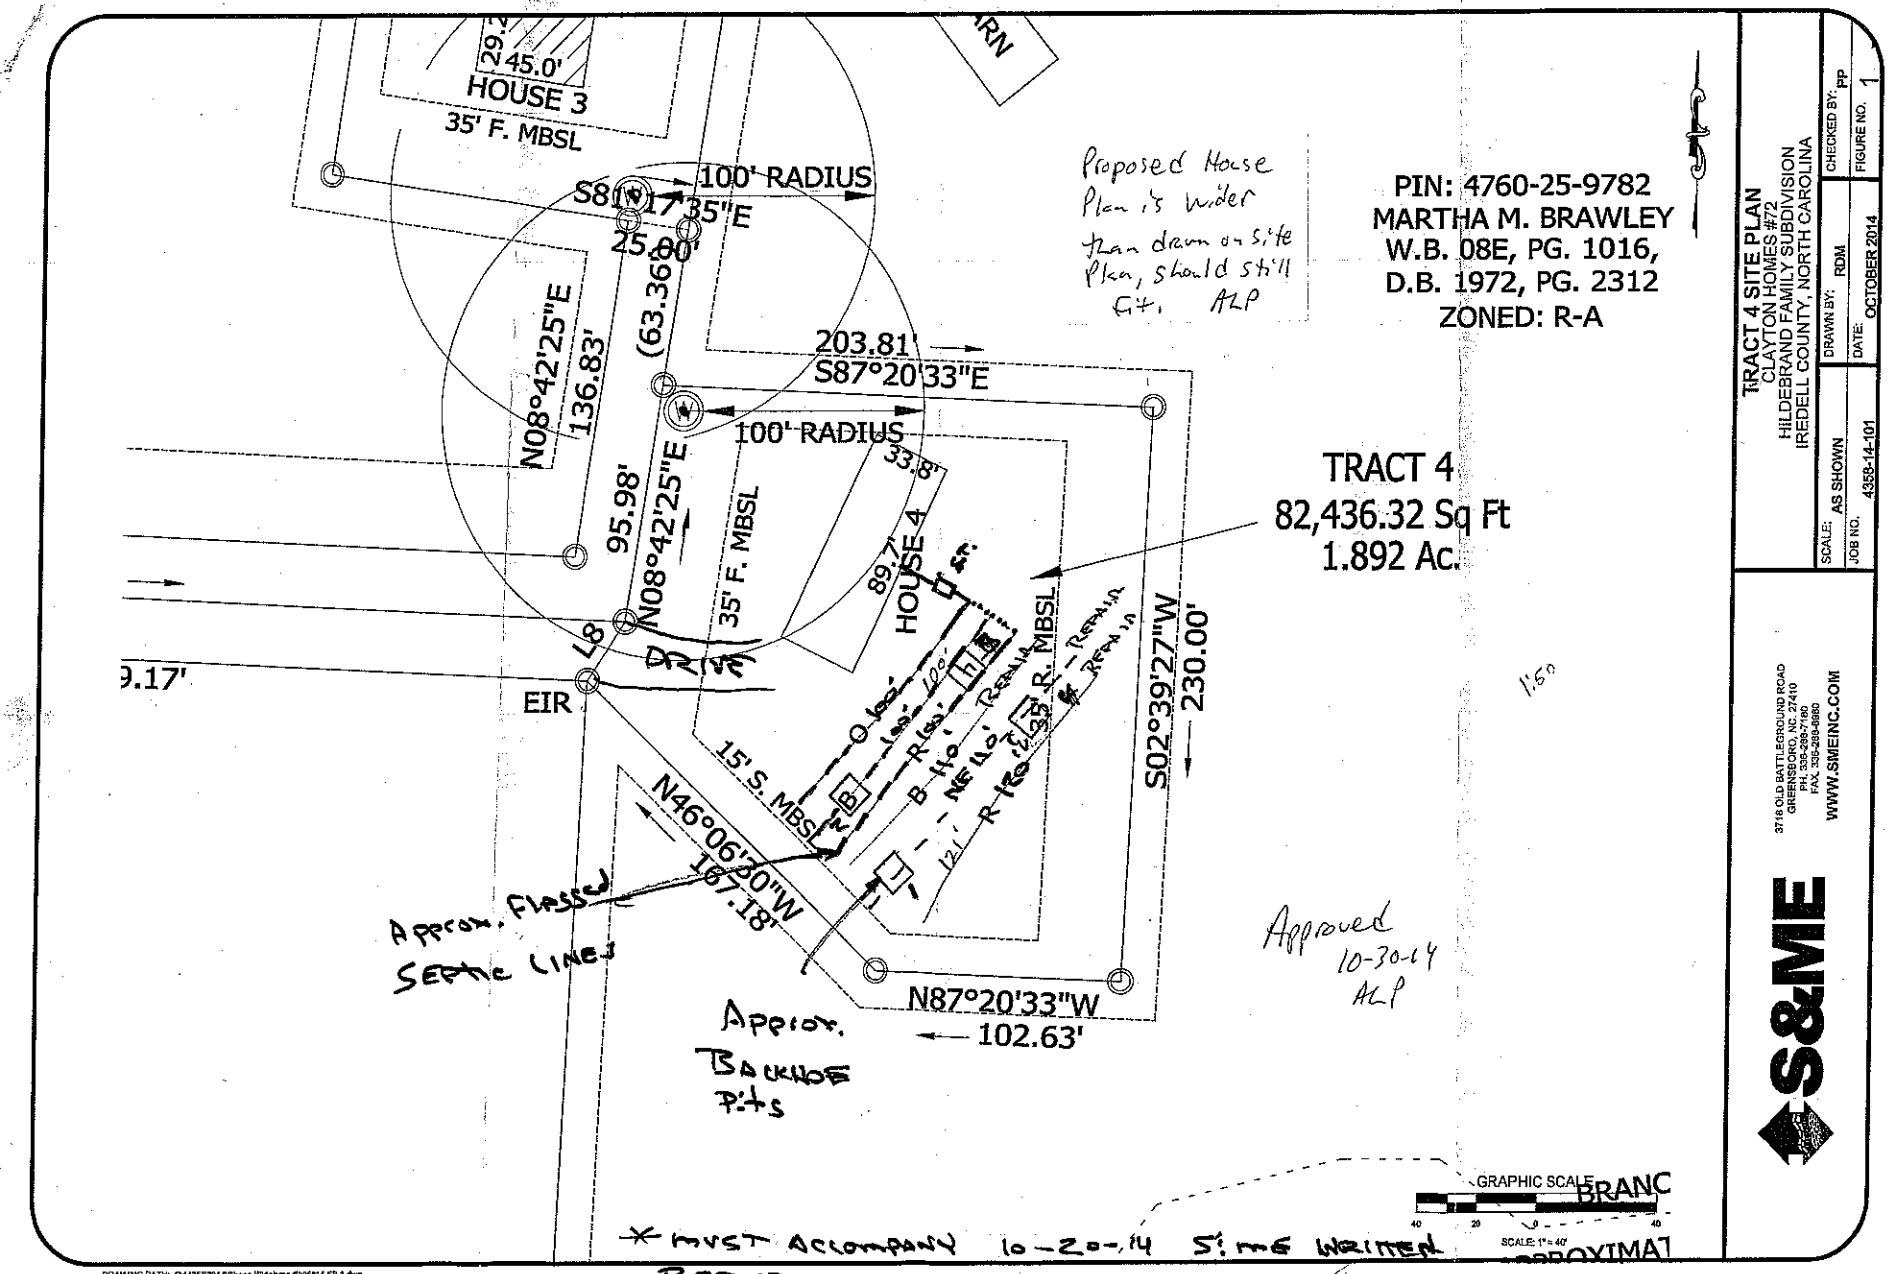
HOUSE 3
35' F. MBSL
45.0'
100' RADIUS
S81°17'35"E
25.00'
(63.36')
N08°42'25"E
136.83'
203.81'
S87°20'33"E
100' RADIUS
95.98'
N08°42'25"E
35' F. MBSL
HOUSE 4
33.8'
89.7'
Proposed House Plan is wider than drawn on site Plan, should still fit. ALP
PIN: 4760-25-9782
MARTHA M. BRAWLEY
W.B. 08E, PG. 1016,
D.B. 1972, PG. 2312
ZONED: R-A
TRACT 4
82,436.32 Sq Ft
1.892 Ac.
S02°39'27"W
230.00'
EIR
15' S. MBSL
N46°06'30"W
167.18'
N87°20'33"W
102.63'
Approx. Flagged Septic Lines
Approx. Backhoe Pits
Approved 10-30-14 ALP
GRAPHIC SCALE
SCALE: 1" = 40'
* MUST ACCOMPANY 10-20-14 SITE WRITTEN REPORT
TRACT 4 SITE PLAN
CLAYTON HOMES #72
HILDEBRAND FAMILY SUBDIVISION
IREDELL COUNTY, NORTH CAROLINA
SCALE: AS SHOWN
DRAWN BY: RDM
CHECKED BY: PP
JOB NO. 4358-14-101
DATE: OCTOBER 2014
FIGURE NO. 1
S&ME
3716 OLD BATTLEGROUND ROAD
GREENSBORO, NC 27410
PH: 336-288-7180
FAX: 336-288-8880
WWW.SMEINC.COM
DRAWING PATH: G:\4358\2014\Shane Hildebrand\4358-14-FIG-1.dwg