IREDELL COUNTY HEALTH DEPARTMENT

Statesville Office (704) 878-5305 Mooresville Office (704) 660-3625 PERMIT # 206483

IMPROVEMENT PERMIT / AUTHORIZATION TO CONSTRUCT / OPERATION PERMIT / EXISTING SYSTEM

PIN # 4760-25-9782 35-3557.149

APPLICANT: Shane Hildebrand APPLICANT ADDRESS: 105 Burgess Cir Mooresville NC

SITE ADDRESS: 149 Buckin Ln PHONE: ALT. PHONE:

SITE DIRECTIONS: Hwy 115 N, TR on Shinnville Rd, TL on Weathers Crk, Property on R, Access in center of Sugar Crk Lp

SUBDIVISION: Hildebrand Family SECTION: LOT # 2 LOT AREA: 30,545sq DESIGN FLOW: 360gpd L.T.A.R.: 0.3

Septic Tank	1000 (gal)	STB	760	Date	3/24/15	☑ New System	☐ Repair	☐ Expansion	System Type: I II III IV V VI	☑ Residence	No. Bedrooms 3	Water Supply
Pump Tank	(gal)	PT		Date		System Description:	Gravity 25% Reduction LP PPBPS			☐ Business	No. Persons 6	☑ Private
Pump Make		Model		Serial #		Repair System Description:				☐ Other	No. Employees	☐ Public
# Nitrification Fields	1	# Lines	3	Linear Ft:	300	Maintenance Agreement Required:	☐ YES	☑ NO		☐ Slab	☑ Crawl Space	☐ Community
Trench Width	36"	Max. Trench Bottom Depth	36"	Gravel Depth	N/A		☑ GRAVITY	☐ PRESSURE		☐ Basement w/plumbing	☐ Basement w/o plumbing	


Comments / Conditions: - DO NOT ISSUE AC UNTIL PLAT IS RECORDED - Plat recorded see attached

INITIAL SITE SKETCH

SEE DESIGN BY S&ME

(Dated 10-20-14, Approved 10-30-14) RLP

AS BUILT SKETCH

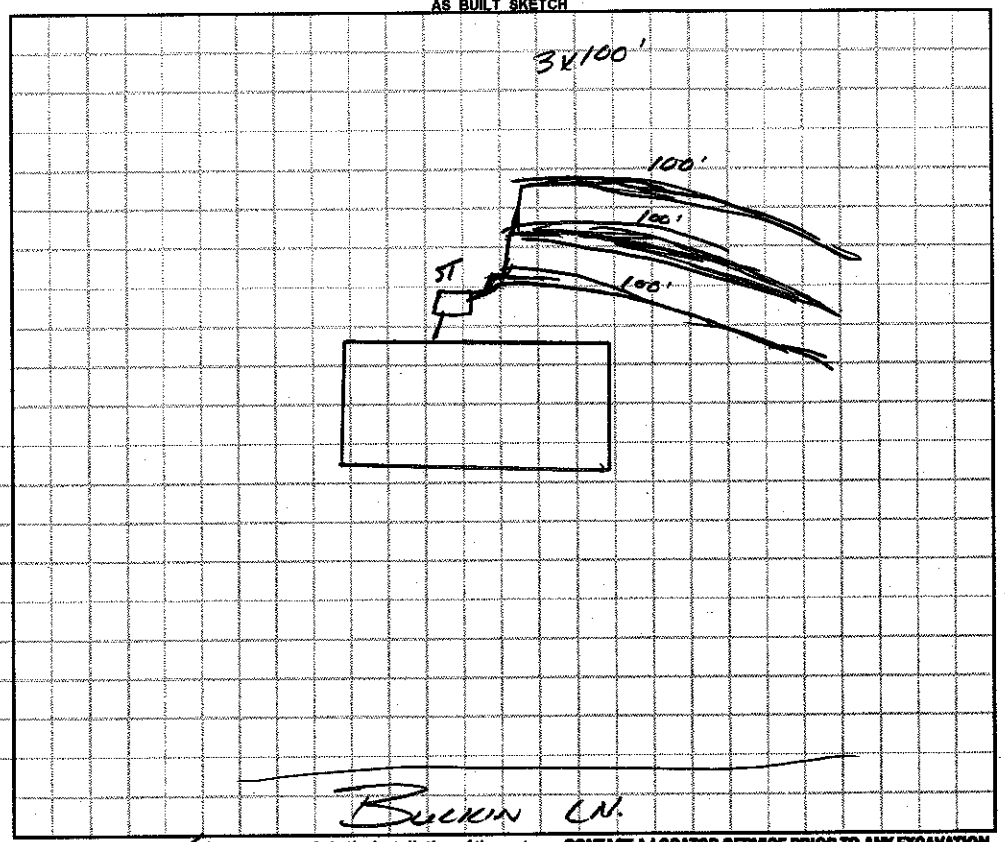

Permit can be suspended or revoked if any false information is supplied toward securing the permit / any unauthorized changes are made to the site / any unauthorized changes are made in the installation of the system. CONTACT A LOCATOR SERVICE PRIOR TO ANY EXCAVATION


☐ IMPROVEMENT PERMIT *with plat* valid without expiration. ☑ IMPROVEMENT PERMIT *with site plan* valid for 60 mos. ☑ AUTHORIZATION TO CONSTRUCT valid for period equal to IMPROVEMENT PERMIT--not to exceed 60 mo.

Owner / Applicant Signature: Deena Hilde Date: 11/3/14 Installed by: Tim

IMPROVEMENT PERMIT by: Date: 10-30-14 OPERATION PERMIT by: APPROVED Date: MAY 15 2015

AUTHORIZATION TO CONSTRUCT by: Date: 3-26-14 Existing System Inspected by: Date:

Health Dept. Copy - WHITE Applicant (Final Approval) - YELLOW Applicant (Conditional Approval) - PINK

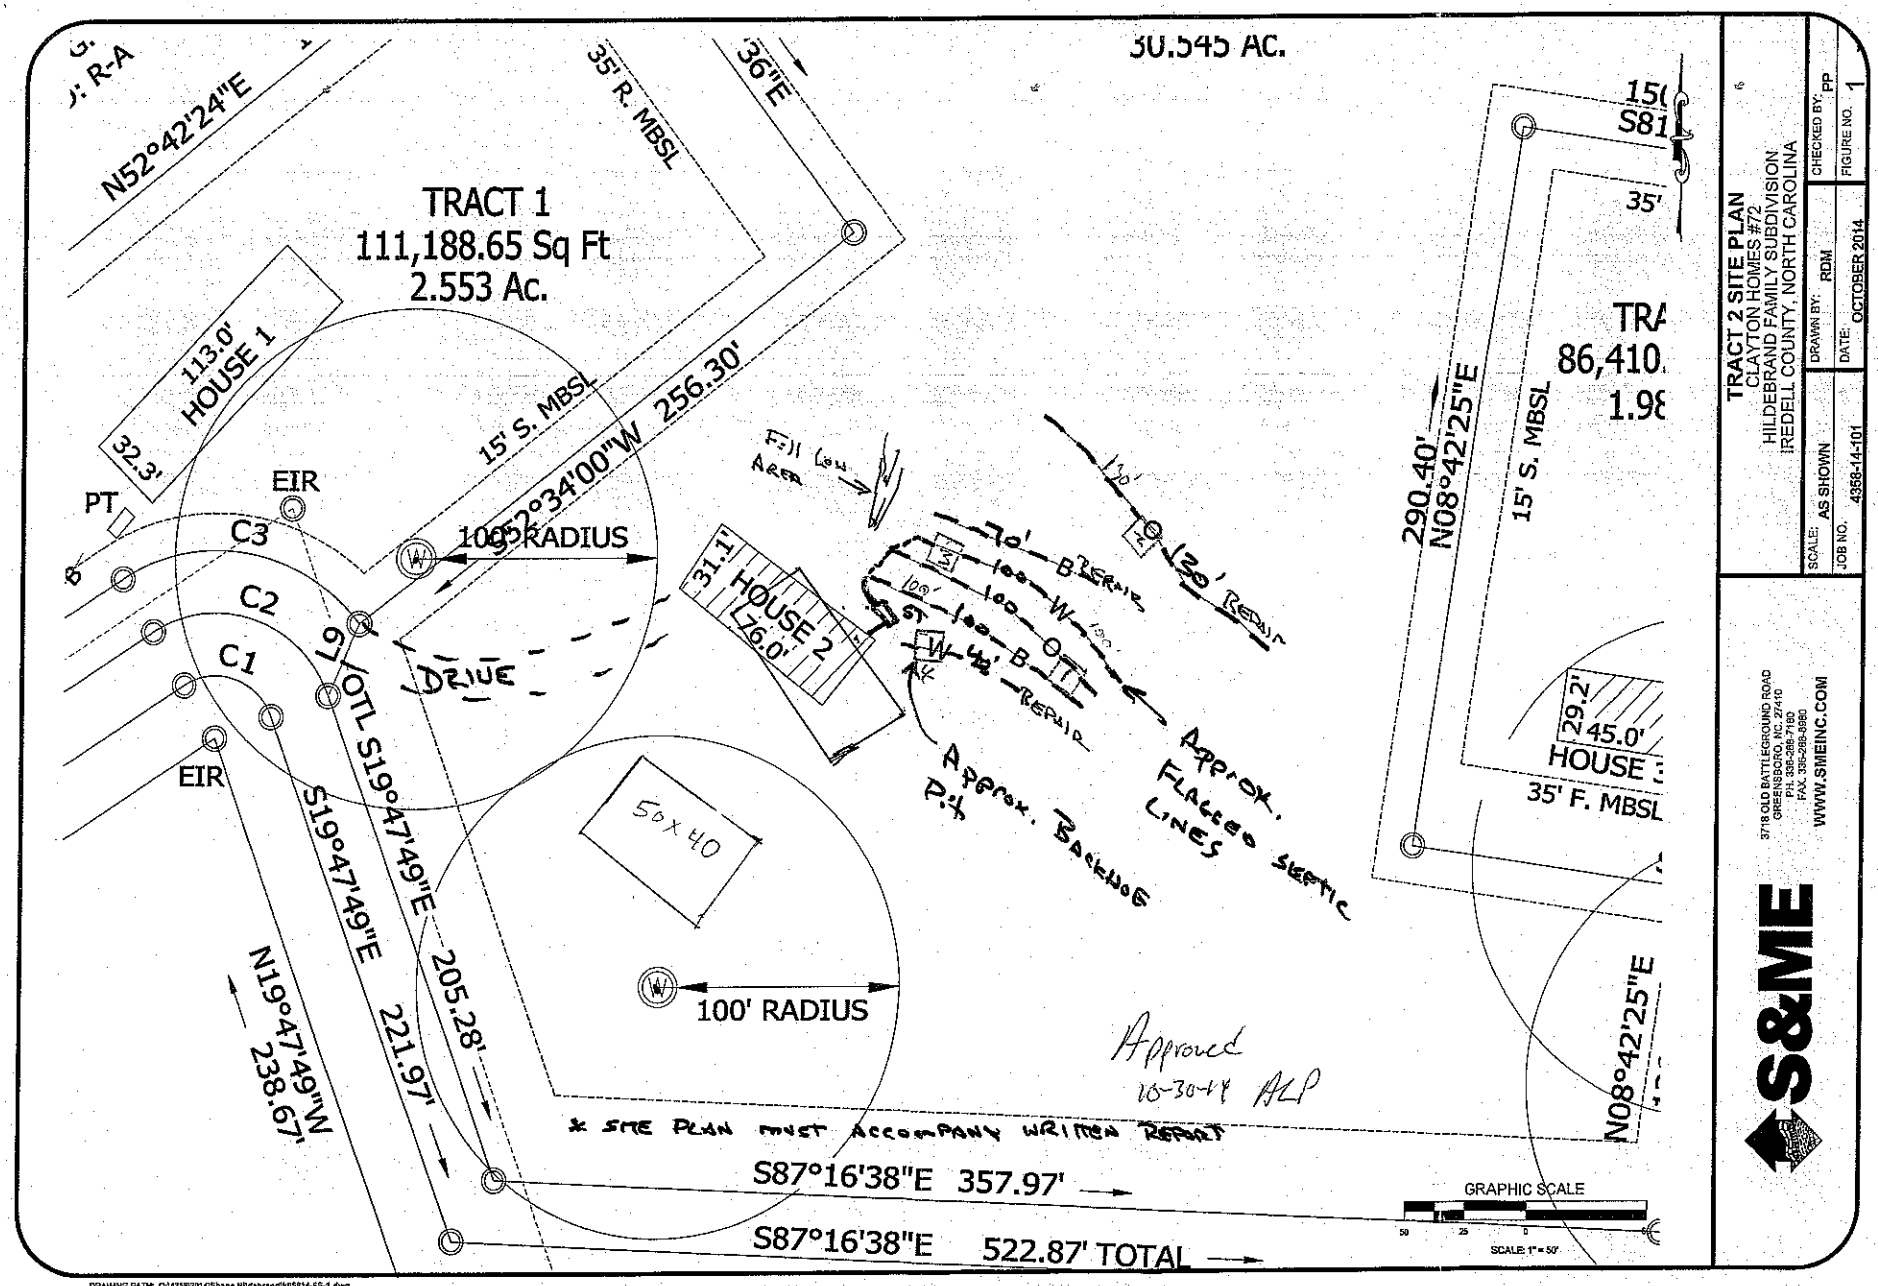
TRACT 1
111,188.65 Sq Ft
2.553 Ac.
30.545 AC.
N52°42'24"E
35' R. MBSL
36"E
113.0'
HOUSE 1
32.3'
15' S. MBSL
S52°34'00"W 256.30'
PT
EIR
C3
C2
C1
100' RADIUS
DRIVE
61
OTL S19°47'49"E 205.28'
S19°47'49"E 221.97'
EIR
N19°47'49"W 238.67'
Fill Low Area
31.1'
HOUSE 2
76.0'
70' BERM
100' W
100' OTL
100' BERM
120' REPAIR
Approx. Flagged Septic Lines
Approx. Backhoe Pit
50x40
100' RADIUS
* SITE PLAN MUST ACCOMPANY WRITTEN REPORT
Approved
10-30-14 ALP
S87°16'38"E 357.97'
S87°16'38"E 522.87' TOTAL
GRAPHIC SCALE
50 25 0
SCALE: 1" = 50'
290.40'
N08°42'25"E
15' S. MBSL
35' F. MBSL
29.2'
45.0'
HOUSE
N08°42'25"E
TRACT 2 SITE PLAN
CLAYTON HOMES #72
HILDEBRAND FAMILY SUBDIVISION
IREDELL COUNTY, NORTH CAROLINA
SCALE: AS SHOWN
DRAWN BY: RDM
CHECKED BY: PP
JOB NO. 4358-14-101
DATE: OCTOBER 2014
FIGURE NO. 1
S&ME
3718 OLD BATTLEGROUND ROAD
GREENSBORO, NC 27410
PH. 336-288-7555
FAX. 336-288-8060
WWW.SMEINC.COM
DRAWING PATH: Q:\4358\2014\Shane Hildebrand\4358514-FS-1.dwg