IREDELL COUNTY HEALTH DEPARTMENT

Authorization to Construct

STATESVILLE 704-878-5305 MOORESVILLE 704-664-5281

IMPROVEMENT PERMIT / ~~CERTIFICATE OF COMPLETION~~ / OPERATION PERMIT / EXISTING SYSTEM INSPECTION

PROPERTY DESCRIPTION NO. 068276 DATE 7/30/97 TAX MAP NO. 4760405074 Watershed: ☐ Yes ☒ No

OWNER OR CONTRACTOR St James Episcopal Church PHONE: Business _____ Home 664-7115

ADDRESS 851 Shinnville Rd. Mooresville, NC. 28115

LOCATION Shinnville Rd. on (R) past Winthrow Creek Rd.

SUBDIVISION No BLOCK / SECTION _____ LOT _____ LOT AREA ~2.5 Ac SITE CLASS. PS DESIGN FLOW < 300 L.T.A.R. .3

Septic Tank: EXISTING Gallons; STB _____ Date _____

Pump Tank: _____ Gallons; PT _____ Date _____

Pump Make: _____ Model _____ Serial No. _____

Nitrification Field: No Fields 1 Square Feet 600 Linear Feet 200

No Lines 2 Trench Width 36" Max Trench Bottom Depth 36" Gravel Depth 12"

☐ New System ☐ Repair System Type: I (II) III, IV, V, VI

System Description: Add to EXISTING SYSTEM

Repair System Description: _____

Maintenance Agreement Required: ☐ Yes ☒ No

☐ House/Mod. Home No. Bedrooms ____

☐ Mobile Home No. Bathrooms ____

☐ Business No. Employees ____

☒ Other UP TO 100 SEAT CHURCH

☐ Slab ☒ Crawl Space ☐ Basement w/plumbing ☐ Basement wo/plumbing


Water Supply: ☑ Individual ☐ Community ☐ Public

Comments:

Comments:

INITIAL SITE SKETCH

1" = 60'

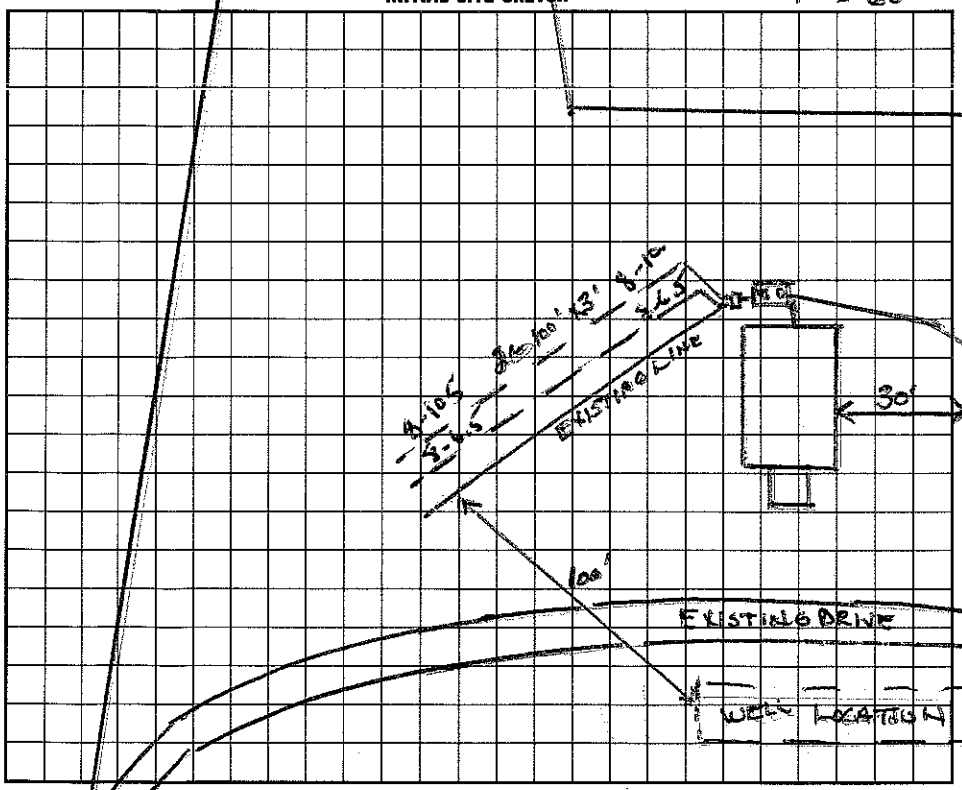

AS BUILT SKETCH

I understand that this permit can be suspended or revoked if any false information is supplied toward securing the permit/any unauthorized changes are made to the site/any unauthorized changes are made in the installation of the system. Improvement Permit is valid for 60 months from date of issuance.

Signed: Joshua W. Brown SHINNVILLE RD. Installed by: F.J. Ervin

Improvement Permit by: Wesley Sparks R.S. date 7/30/97 Certificate of Completion by: Wesley Sparks R.S. date 2/18/98

~~Existing System Inspection~~ by: Wesley Sparks R.S. date 7/30/97 Operation Permit by: Wesley Sparks R.S. date 2/18/98

HEALTH DEPT. COPY: WHITE INSPECTION COPY (FINAL): GREEN OWNER COPY (FINAL): YELLOW INSPECTION COPY (INITIAL): PINK OWNER COPY (INITIAL): GOLD