4760454818

IREDELL COUNTY HEALTH DEPARTMENT

STATESVILLE 704-878-5305 MOORESVILLE 704-664-5281

IMPROVEMENT PERMIT / CERTIFICATE OF COMPLETION / OPERATION PERMIT / EXISTING SYSTEM INSPECTION

PROPERTY DESCRIPTION NO. 17912 DATE 3/3/94 TAX MAP NO. 4660 A 33 Watershed: ☐ Yes ☒ No

OWNER OR CONTRACTOR Kenneth Lyttle PHONE: Business _____ Home 664-3325

ADDRESS Rt 2 Box 293 Cleveland NC. 28013

LOCATION Brawley Rd., .9 mile on (L) from Shumaker Rd.

SUBDIVISION No BLOCK / SECTION _____ LOT _____ LOT AREA ~ 4 ± Ac SITE CLASS. P DESIGN FLOW 240 L.T.A.R. .2 - .25

Septic Tank: 1000 Gallons; STB 825 Date 3/4/94
Pump Tank: _____ Gallons; PT _____ Date _____
Pump Make: _____ Model _____ Serial No. _____
Nitrification Field: No Fields 1 Square Feet 1200 Linear Feet 400
No Lines 3 Trench Width 31 Max Trench Bottom Depth 36" Gravel Depth 12"

☒ New System ☐ Repair System Type: I (II) III, IV, V, VI
System Description: CONV - DIST BOX
Repair System Description: _____
Maintenance Agreement Required: ☐ Yes ☒ No

☒ House/Mod. Home No. Bedrooms 2
☐ Mobile Home No. Bathrooms 1
☐ Business No. Employees ____
☐ Other _____


☐ Slab ☒ Crawl Space ☐ Basement w/plumbing ☐ Basement wo/plumbing

Water Supply:
☒ Individual
☐ Community
☐ Public

Comments:
Future Repair

Comments:
installed as shown on Imp. Permit

INITIAL SITE SKETCH

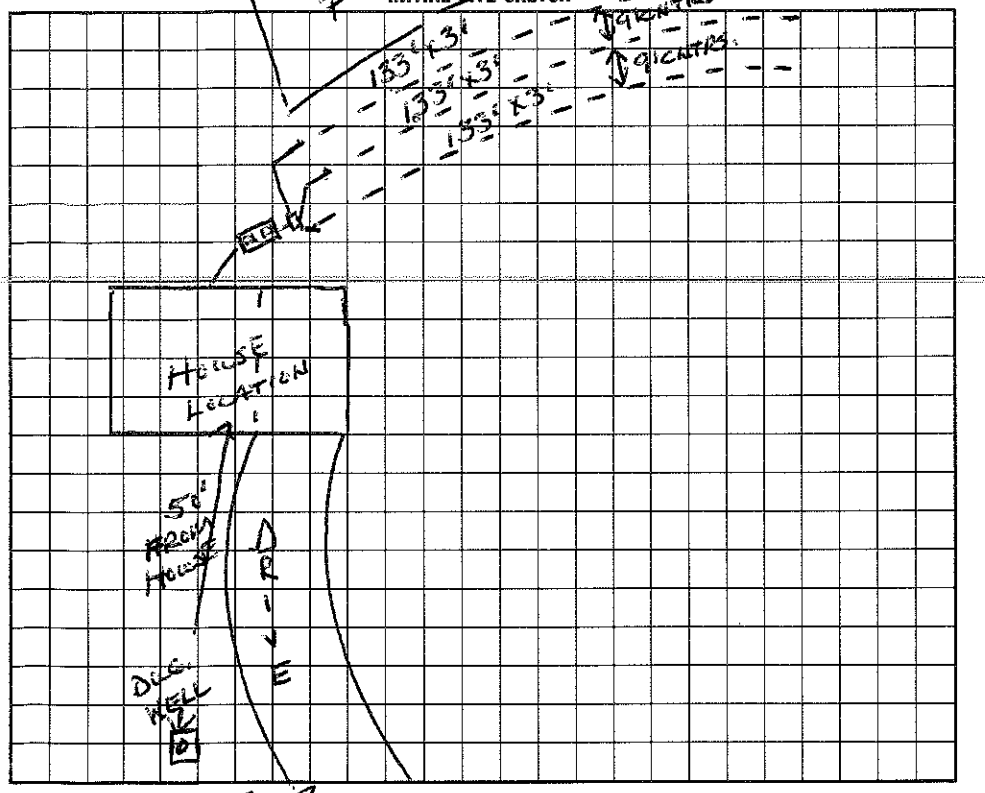

AS BUILT SKETCH

I understand that this permit can be suspended or revoked if any false information is supplied toward securing the permit/any unauthorized changes are made to the site/any unauthorized changes are made in the installation of the system. Improvement Permit is valid for 60 months from date of issuance.

Signed: _____

Improvement Permit by: Wesley Sparks R.S. date 3/3/94

Existing System Inspection by: _____ date _____

Installed by: Home Builders Const.

Certificate of Completion by: Wesley Sparks R.S. date 5/13/94

Operation Permit by: _____ date _____

HEALTH DEPT. COPY: WHITE INSPECTION COPY (FINAL): GREEN OWNER COPY (FINAL): YELLOW INSPECTION COPY (INITIAL): PINK OWNER COPY (INITIAL): GOLD