4760508544

IREDELL COUNTY HEALTH DEPARTMENT

STATESVILLE 704-878-5305 MOORESVILLE 704-664-5281

IMPROVEMENT PERMIT / CERTIFICATE OF COMPLETION / OPERATION PERMIT / EXISTING SYSTEM INSPECTION

PROPERTY DESCRIPTION NO. Repair DATE 9/18/95 TAX MAP NO. Repair Watershed: ☒ Yes ☐ No

OWNER OR CONTRACTOR Terry Pardew PHONE: Business 663-2923 Home

ADDRESS 904 Statesville Rd. Mooresville, NC. 28115

LOCATION on (R) before Shimms Store

SUBDIVISION N/A BLOCK / SECTION LOT LOT AREA Empty SITE CLASS. PS DESIGN FLOW 175 L.T.A.R. .25

Septic Tank: Existing Gallons; STB Date

Pump Tank: Gallons; PT Date

Pump Make: Model Serial No.

Nitrification Field: No Fields 1 Square Feet 700 Linear Feet 250

No Lines 4 Trench Width 36" Max Trench Bottom Depth 36" Gravel Depth 14"

☐ New System ☒ Repair System Type: I (II) III, IV, V, VI

System Description: GRAV CONVENTIONAL

Repair System Description:

Maintenance Agreement Required: ☐ Yes ☐ No

☐ House/Mod. Home No. Bedrooms

☐ Mobile Home No. Bathrooms

☒ Business No. Employees 7

☐ Other 175 G.P.D.


☐ Slab ☒ Crawl Space ☐ Basement w/plumbing ☐ Basement wo/plumbing

Water Supply:
☒ Individual
☐ Community
☐ Public

Comments:

Comments: Installed substantially as shown

INITIAL SITE SKETCH

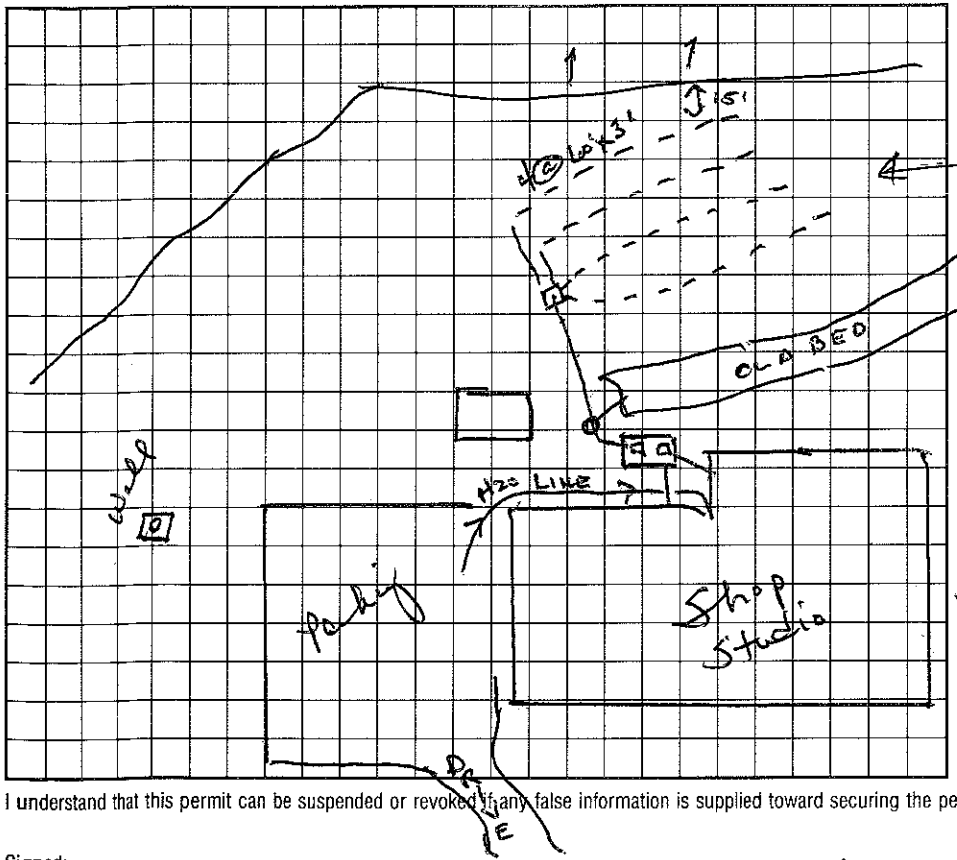

AS BUILT SKETCH

I understand that this permit can be suspended or revoked if any false information is supplied toward securing the permit/any unauthorized changes are made to the site/any unauthorized changes are made in the installation of the system.

Signed:

Improvement Permit by: Wesley Sparks RS. date 9/18/95

Existing System Inspection by: date

Installed by: Tim Ammons

Certificate of Completion by: date

Operation Permit by: J. Johnson, RS date 10/13/95

HEALTH DEPT. COPY: WHITE INSPECTION COPY (FINAL): GREEN OWNER COPY (FINAL): YELLOW INSPECTION COPY (INITIAL): PINK OWNER COPY (INITIAL): GOLD