$550.00 1130

IREDELL COUNTY HEALTH DEPARTMENT

STATESVILLE 704-878-5305 MOORESVILLE 704-664-5281

IMPROVEMENT PERMIT / AUTHORIZATION TO CONSTRUCT / OPERATION PERMIT / EXISTING SYSTEM INSPECTION

PERMIT# 140345 PIN# 4760569459 DATE 4-19-07

OWNER OR APPLICANT Shelley Construction PHONE: Business 704 258 3648 Home

ADDRESS 116 Crossbow Ln Mooresville, NC 28117

LOCATION Hwy 21 North TR Shinnville Rd TL Brawley Rd ~ 1/2 mile on corner of Strawberry Hill Ln.

SUBDIVISION Strawberry Hills Acres BLOCK / SECTION 2 LOT 8 LOT AREA .65 Acre SITE CLASS PS DESIGN FLOW 360 gpd L.T.A.R. .3 to .25

Septic Tank: 1000 Gallons: STB 794 Date 7-27-01

Pump Tank: 1000 Gallons: PT 27 Date 4-9-01

1/3 HP Pump Make: Goulds Model WE0312MW Serial No.

Nitrification Field: No Fields 1 Square Feet 900' Linear Feet 300'

No Lines 4 Trench Width 36" Max Trench Bottom Depth 36" Gravel Depth N/A

☒ New System ☐ Repair ☐ Expansion System Type: I II (III) IV V VI

System Description: Pump - 25% Reduction

Repair System Description: LD - Panel Block

Maintenance Agreement Required: ☐ Yes ☒ No

☐ Gravity ☒ Pressure ☐ Slab ☒ Crawl Space ☐ Basement w/plumbing ☐ Basement wo/plumbing

☒ House/Mod. Home ☐ Mobile Home ☐ Business ☐ Other


No. Bedrooms 3 No. Persons No. Employees

Water Supply: ☒ Individual ☐ Public ☐ Community

Comments:/Conditions: Do Not set House any further back than as Shown. Keep Septic 5ft minimum from house, keep well 40ft from property line.

Comments:/Conditions: * Do Not Cut for House pad, backfill around house.
8/30/07 Checked tanks, lines & pressure Quick 4

INITIAL SITE SKETCH Scale 1:50

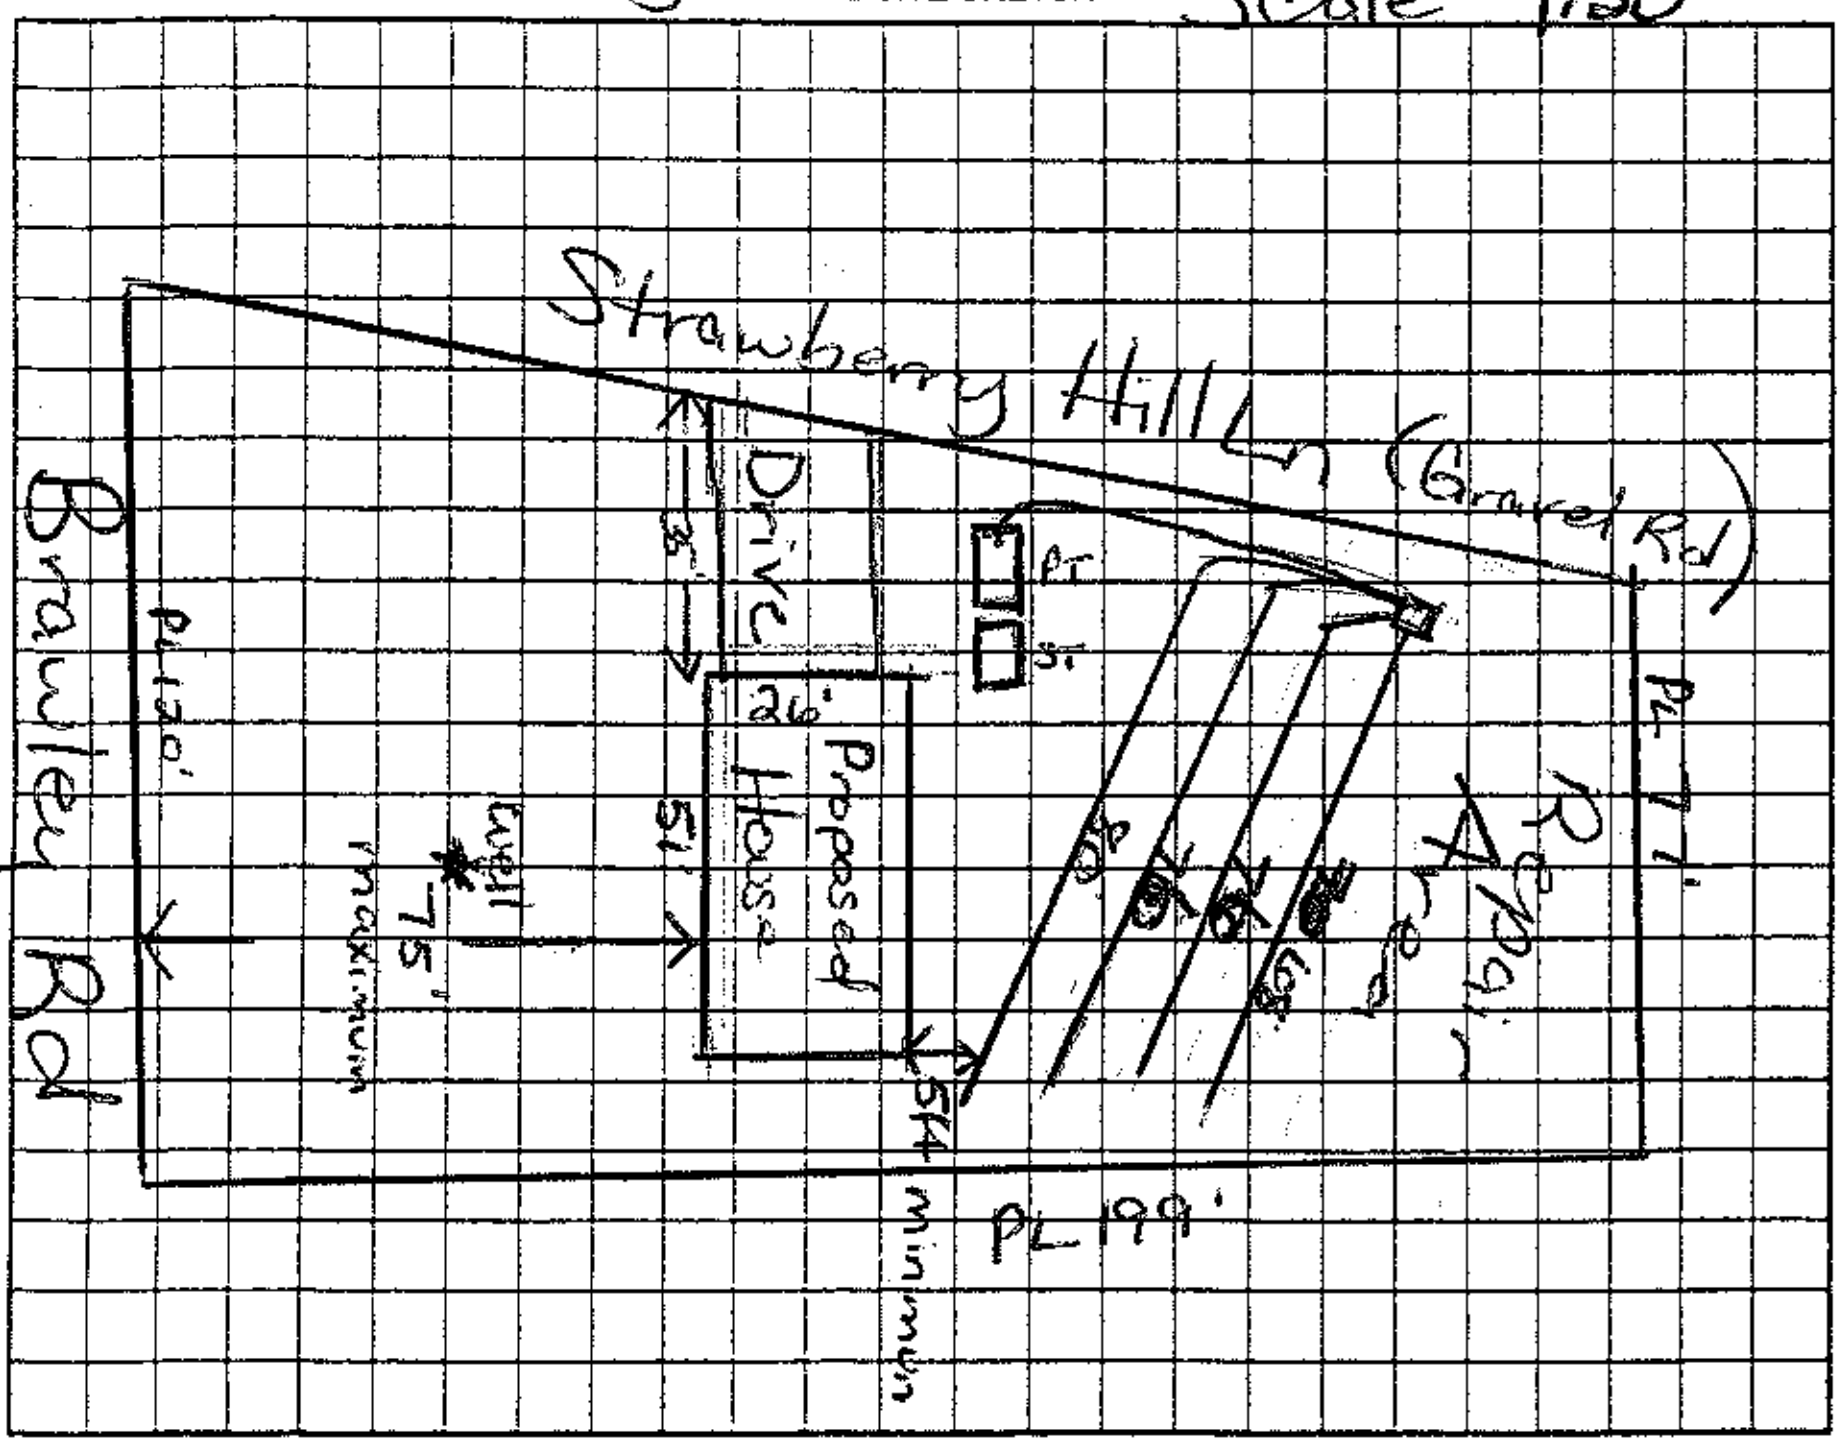

AS BUILT SKETCH

Permit can be suspended or revoked if any false information is supplied toward securing the permit/any unauthorized changes are made to the site/any unauthorized changes are made in the installation of the system. Improvement Permit with plat valid without expiration ☐ Improvement Permit with site plan valid for sixty months ☐ Authorization to Construct is valid for a period equal to that of Improvement Permit – not to exceed sixty months.

Signed: K Shelley date 5/9/07

Improvement Permit by: Maria H. Dolson RS date 4/19/07

Authorization to Construct by: Maria H. Dolson RS date 4/23/07

Installed by: Larry Beam

Operation Permit by: Maria H. Dolson RS date 1/15/08

Existing System Inspection by: date

HEALTH DEPT. COPY: WHITE OWNER COPY (FINAL): YELLOW OWNER COPY (INITIAL): PINK