IREDELL COUNTY HEALTH DEPARTMENT

STATESVILLE 704-878-5305 MOORESVILLE 704-664-5281

IMPROVEMENT PERMIT / AUTHORIZATION TO CONSTRUCT / OPERATION PERMIT / EXISTING SYSTEM INSPECTION

PERMIT# ~~15041~~ 173564 PIN# 4760590739 DATE 6-5-08

OWNER OR APPLICANT Freedom Homes / Brazos Dev. PHONE: Business 704-529-7960 Home

ADDRESS 1042 Charlotte Hwy Cleveland NC 27103

LOCATION 115 TR Shinnville, TL Brawley, TR Fairhaven on R 144 Fairhaven

SUBDIVISION ~~Fair~~ Haven BLOCK / SECTION LOT 25 LOT AREA .55 AC SITE CLASS. PS DESIGN FLOW 360 L.T.A.R. .4

Septic Tank: 1000 Gallons: STB 786 Date 9-7-11

Pump Tank: 1000 Gallons: PT 32 Date 9-5-11

Pump Make: Gouds Model WE 0511H Serial No.

Nitrification Field: No Fields 1 Square Feet 675' Linear Feet 225'

No Lines 3@75' Trench Width 36" Max Trench Bottom Depth 24" Gravel Depth — ☐ Gravity ☒ Pressure

☒ New System ☐ Repair ☐ Expansion System Type: I II III IV V VI

System Description: PM 25% Reduction

Repair System Description: PM 25% Reduction

Maintenance Agreement Required: ☐ Yes ☒ No

☒ House/Mod. Home No. Bedrooms 3

☒ Mobile Home No. Persons

☐ Business No. Employees

☐ Other


Water Supply: ☒ Individual ☐ Public ☐ Community

☐ Slab ☒ Crawl Space ☐ Basement w/plumbing ☐ Basement wo/plumbing


Comments:/Conditions: Keep upper drain line min' 54' Away from back prop. line because of neighbors well / use 24" trench bottom to stay 12" above saprolite

Comments:/Conditions:

INITIAL SITE SKETCH

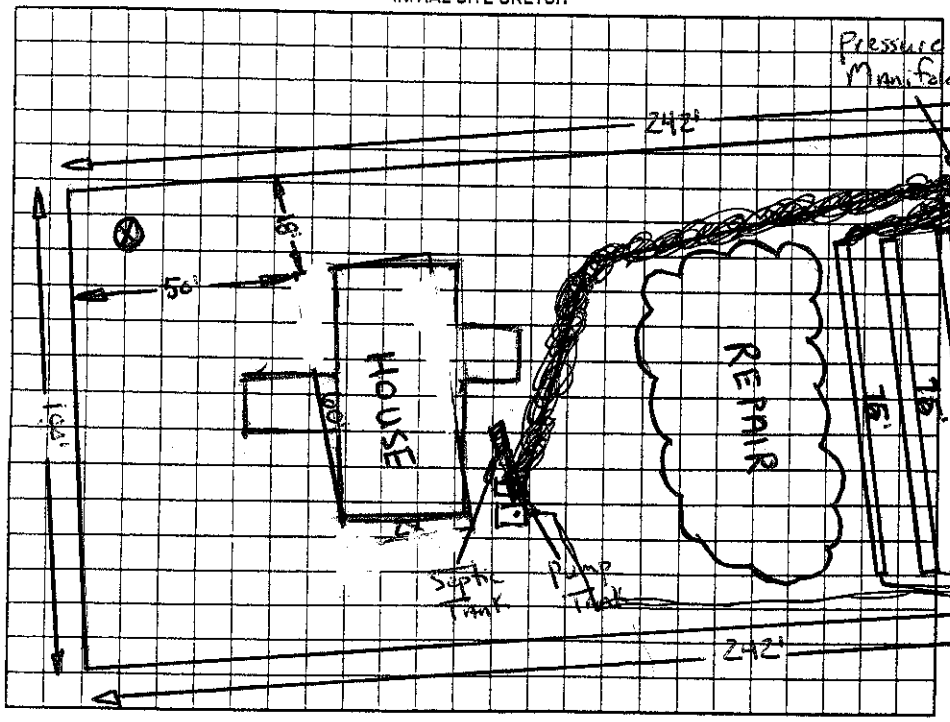

AS BUILT SKETCH

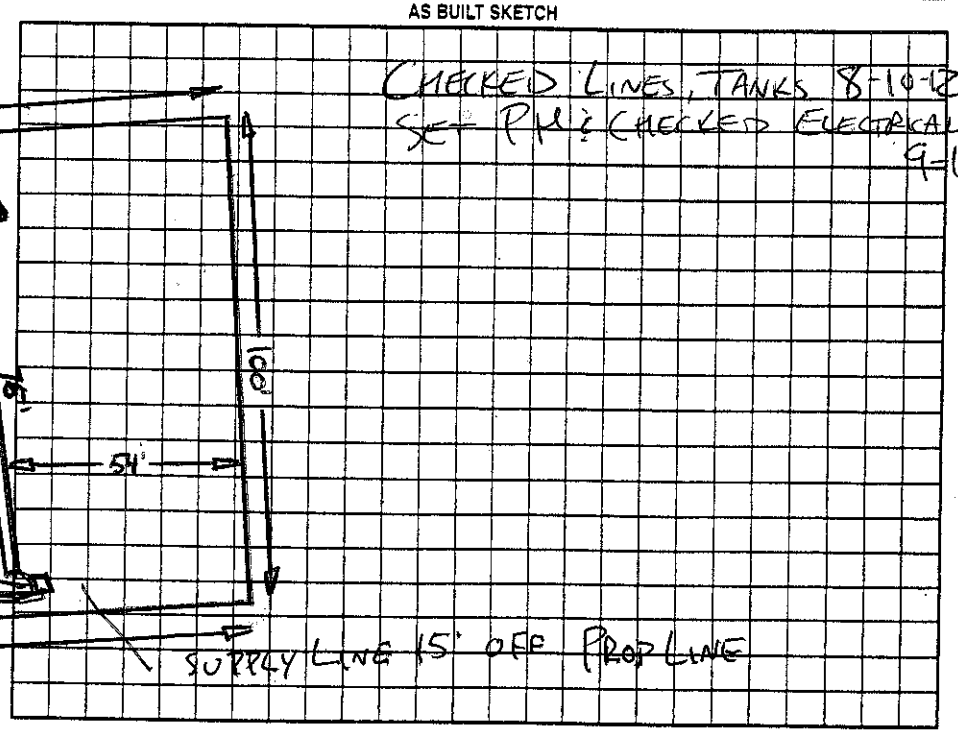

Permit can be suspended or revoked if any false information is supplied toward securing the permit/any unauthorized changes are made to the site/any unauthorized changes are made in the installation of the system. Improvement Permit with plat valid without expiration ☐ / Improvement Permit with site plan valid for sixty months ☒ Authorization to Construct is valid for a period equal to that of Improvement Permit – not to exceed sixty months.

Signed: Deena Mee date 6/6/08

Improvement Permit by: date 6-5-08

Authorization to Construct by: date ~~6-5-08~~

Installed by:

Operation Permit by: ADAN REHS date 9-13-12

Existing System Inspection by: date

HEALTH DEPT. COPY: WHITE OWNER COPY (FINAL): YELLOW OWNER COPY (INITIAL): PINK

Sandy Melville 7-2-12