IREDELL COUNTY HEALTH DEPARTMENT

Statesville Office (704) 878-5305 Mooresville Office (704) 660-3625 PERMIT # 215983

IMPROVEMENT PERMIT / AUTHORIZATION TO CONSTRUCT / OPERATION PERMIT / EXISTING SYSTEM

PIN # 4760-59-3644

APPLICANT: FREEDOM HOMES APPLICANT ADDRESS: 1124 CHARLOTTE HWY TROUTMAN

SITE ADDRESS: 159 FAIRHAVEN LN., CLEVELAND, NC PHONE: 704-528-7960 ALT. PHONE:

SITE DIRECTIONS: SHWANVILLE, TL BRAWLEY, TR FAIRHAVEN


SUBDIVISION: FAIR HAVEN SECTION: -1- LOT # 9 LOT AREA: .85 AC DESIGN FLOW: 300 L.T.A.R.: .35

Septic Tank	1000 (gal)	STB	1012	Date	1-20	☒ New System ☐ Repair ☐ Expansion	System Type: I II (III) IV V VI	☒ Residence	No. Bedrooms 3
Pump Tank	(gal)	PT		Date		System Description:	25% REDUCTION	☐ Business	No. Persons
Pump Make	Model			Serial #		Repair System Description:	SAME	☐ Other	No. Employees
# Nitrification Fields	1 # Lines	5		Linear Ft:	257'	Maintenance Agreement Required:	☐ YES ☒ NO	☐ Slab	☒ Crawl Space
Trench Width	36" Max. Trench Bottom Depth	31"		Gravel Depth	—		☒ GRAVITY ☐ PRESSURE	☐ Basement w/plumbing	☐ Basement w/o plumbing

Water Supply: ☒ Private ☐ Public ☐ Community

Comments / Conditions:

INITIAL SITE SKETCH

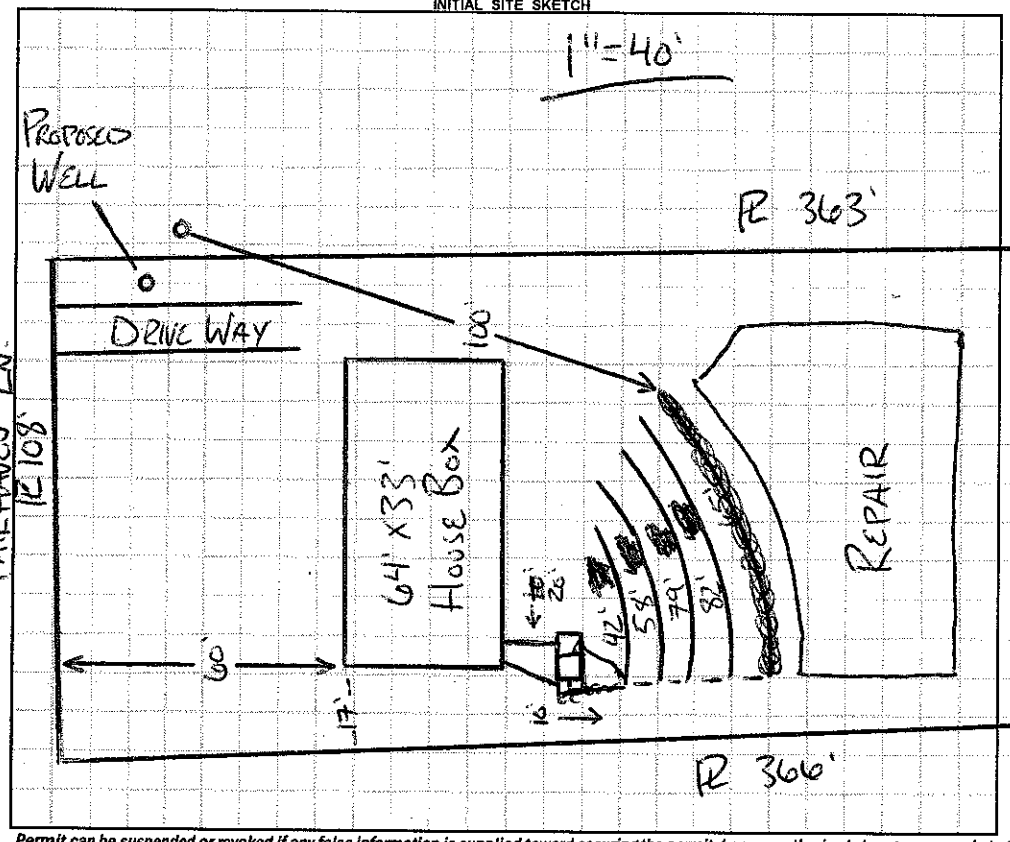

AS BUILT SKETCH

Permit can be suspended or revoked if any false information is supplied toward securing the permit / any unauthorized changes are made to the site / any unauthorized changes are made in the installation of the system. **CONTACT A LOCATOR SERVICE PRIOR TO ANY EXCAVATION**

☐ **IMPROVEMENT PERMIT** *with plat valid without expiration.* ☐ **IMPROVEMENT PERMIT** *with site plan valid for 60 mos.* ☒ **AUTHORIZATION TO CONSTRUCT** *valid for period equal to IMPROVEMENT PERMIT--not to exceed 60 mo.*

Owner / Applicant Signature: Date: 2/29/16 Installed by: CRAIG THOMPSON

IMPROVEMENT PERMIT by: Date: APPROVED FEB 24 2016 OPERATION PERMIT by: Date: APPROVED MAY 03 2016

AUTHORIZATION TO CONSTRUCT by: Date: APPROVED FEB 24 2016 Existing System Inspected by: Date:

Health Dept. Copy - WHITE Applicant (Final Approval) - YELLOW Applicant (Conditional Approval) - PINK