IREDELL COUNTY HEALTH DEPARTMENT

STATESVILLE 704-878-5305 MOORESVILLE 704-664-5281

IMPROVEMENT PERMIT / AUTHORIZATION TO CONSTRUCT / OPERATION PERMIT / EXISTING SYSTEM INSPECTION

PERMIT# No. REPAIR PIN# No 4760 61 4144 DATE 7/12/04

OWNER OR CONTRACTOR Wade Holt PHONE: Business 704-264-3742 Home

ADDRESS 952 Shinnville Rd. Mooresville, NC. 28115

LOCATION Shinnville Rd.

SUBDIVISION No BLOCK / SECTION LOT No LOT AREA Acreage SITE CLASS. PS DESIGN FLOW 360 L.T.A.R. .3

Septic Tank: EXISTING Gallons; STB Date

Pump Tank: Gallons; PT Date

Pump Make: Model Serial No.

Nitrification Field: No Fields 1 Square Feet 900 Linear Feet 300 ±

No Lines 3@100 Trench Width 3 Max Trench Bottom Depth 3' Gravel Depth No

☐ New System ☒ Repair System Type: I, II, (III), IV, V, VI

System Description: Trench - Type 3

Repair System Description: Trench - Type 3

Maintenance Agreement Required: ☐ Yes ☒ No

☒ House/Mod. Home No. Bedrooms 3

☐ Mobile Home No. Bathrooms 1.5

☐ Business No. Employees

☐ Other


☐ Slab ☒ Crawl Space ☐ Basement w/plumbing ☐ Basement wo/plumbing

Water Supply: ☒ Individual ☐ Public ☐ Community

Comments:/Conditions:

Comments:/Conditions: T Replace in tank, spread levelers in D/B

INITIAL SITE SKETCH

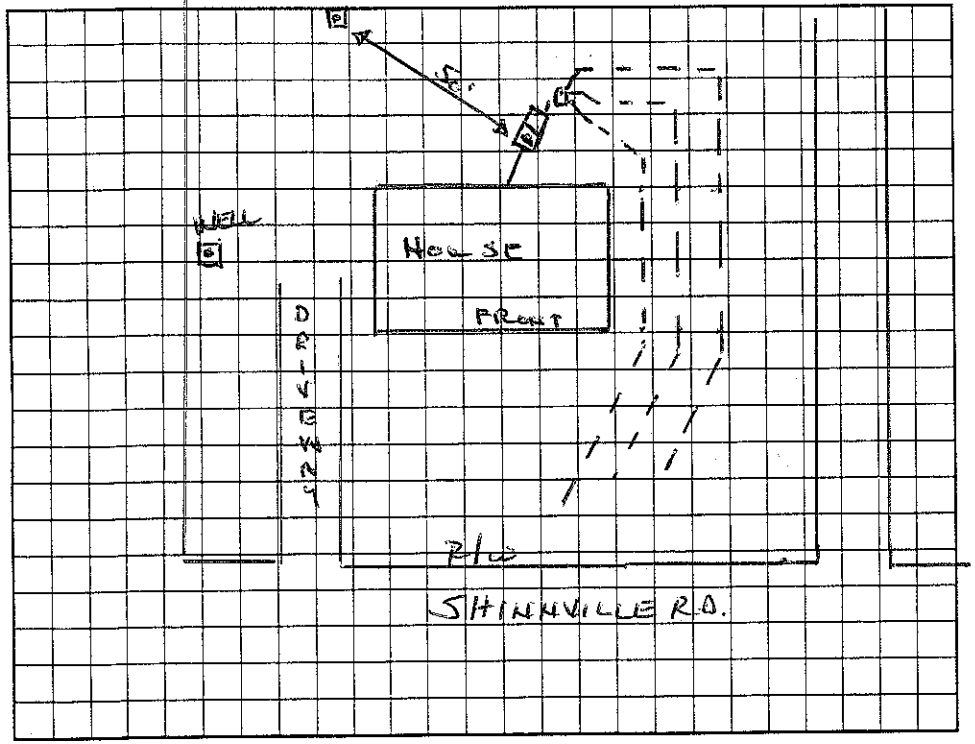

AS BUILT SKETCH

Permit can be suspended or revoked if any false information is supplied toward securing the permit/any unauthorized changes are made to the site/any unauthorized changes are made in the installation of the system. Improvement Permit with plat valid without expiration. Improvement Permit with site plan valid for sixty months. Authorization to Construct is valid for a period equal to that of Improvement Permit – not to exceed sixty months.

Signed: Wade B. Holt date 7-12-04

Improvement Permit by: Wesley Sparks R.S. date 7/12/04

Authorization to Construct by: Wesley Sparks R.S. date 7/12/04

Installed by: NE Hendrix & Sons

Operation Permit by: Wesley Sparks R.S. date 7/20/04

Existing System Inspection by: date

HEALTH DEPT. COPY: WHITE OWNER COPY (FINAL): YELLOW OWNER COPY (INITIAL): PINK