IREDELL COUNTY HEALTH DEPARTMENT

STATESVILLE 704-878-5305 Paid 125.00 MOORESVILLE 704-664-5

IMPROVEMENT PERMIT / AUTHORIZATION TO CONSTRUCT / OPERATION PERMIT / EXISTING SYSTEM INSPECTION

PERMIT# 091459 PIN# 4760 61 4958

OWNER OR CONTRACTOR James Sanford DATE 9/26/00

ADDRESS 989 Shimwell Rd. Mooresville, NC. 28115 PHONE: Business Home 664-3562

LOCATION 115 N TR Shimwell Rd, on (L) B 4 Brawley Rd.

SUBDIVISION No BLOCK / SECTION LOT LOT AREA .74 Ac SITE CLASS RS DESIGN FLOW 240 L.T.A.R. .3

Septic Tank: 1000 Gallons; STB 825 Date 10/2/00

Pump Tank: 1000 Gallons; PT 307 Date 10/2/00

Pump Make: ZOELLER Model N-98 B Serial No.

Nitrification Field: No Fields 1 Square Feet 800 Linear Feet 266

No Lines 3 @ 87' Trench Width 3' Max Trench Bottom Depth 3'

[X] New System [ ] Repair System Type: I, II, (III) IV, V, VI

System Description: Pressure Man — Conventional

Repair System Description: Pressure - 16" PPBS

Maintenance Agreement Required: [ ] Yes [X] No

Gravel Depth 12"

[ ] House/Mod. Home [X] Mobile Home [ ] Business [ ] Other

No. Bedrooms 2 No. Bathrooms 2 No. Employees


[ ] Slab [X] Crawl Space [ ] Basement w/plumbing [ ] Basement wo/plumbing

Water Supply: [ ] Individual [ ] Public [ ] Community BROTHERS


Comments:/Conditions:

Comments:/Conditions:

INITIAL SITE SKETCH

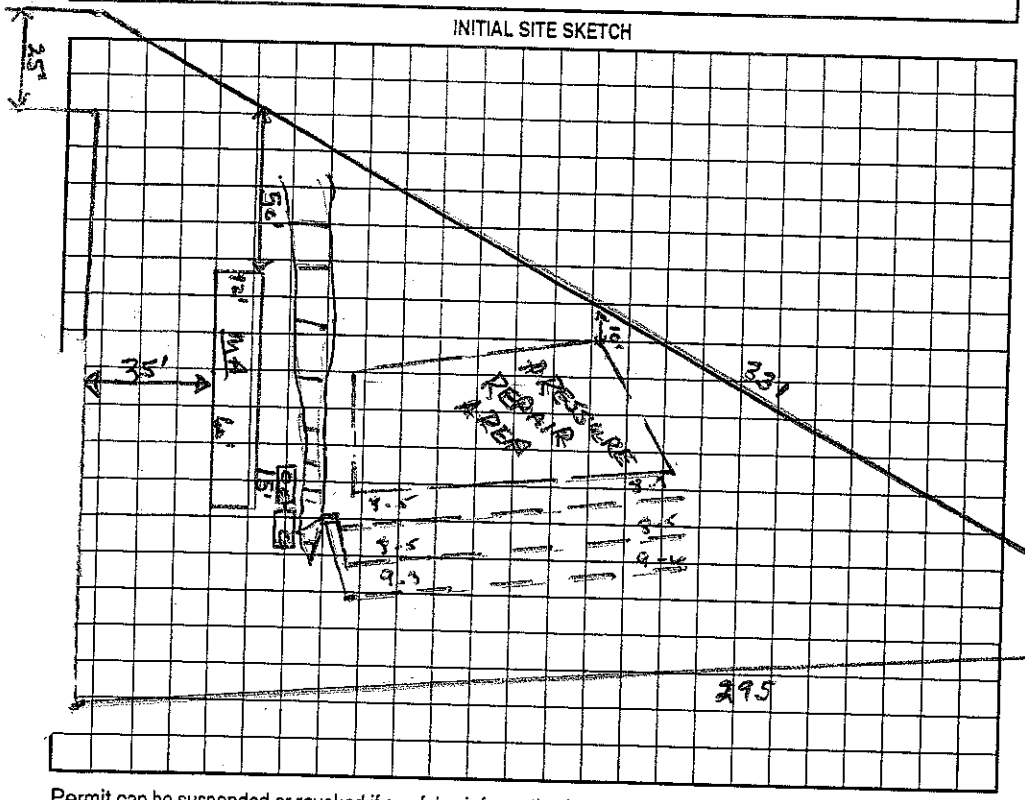

AS BUILT SKETCH

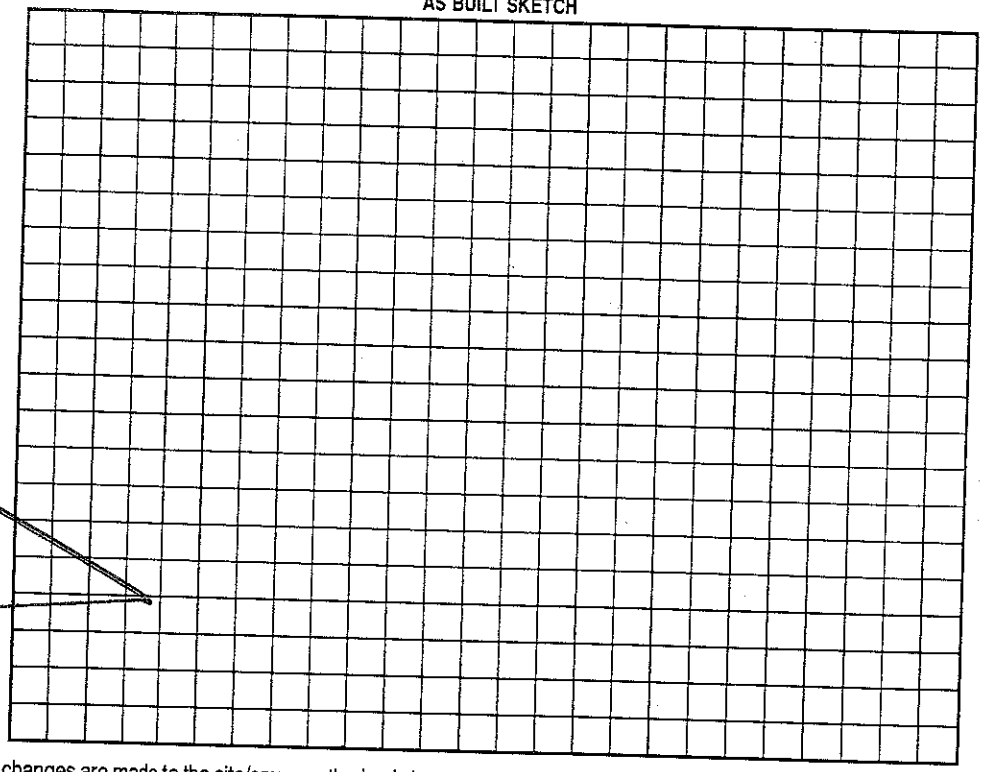

Permit can be suspended or revoked if any false information is supplied toward securing the permit/any unauthorized changes are made to the site/any unauthorized changes are made in the installation of the system. Improvement Permit with plat valid without expiration. Improvement Permit with site plan valid for sixty months. Authorization to Construct is valid for a period equal to that of Improvement Permit -- not to exceed sixty months.

Signed: James Sanford date 10-2-00

Improvement Permit by: Wesley Sparks RS. date 9/26/00

Authorization to Construct by: Wesley Sparks RS. date 9/26/00

Installed by: Rowan Septic Tank

Operation Permit by: Wesley Sparks RS date 12/15/00

Existing System Inspection by: date

HEALTH DEPT. COPY: WHITE OWNER COPY (FINAL): YELLOW OWNER COPY (INITIAL): PINK