IREDELL COUNTY HEALTH DEPARTMENT

4760-61-5785 (11:00) - 11:30

STATESVILLE 704-878-5305 MOORESVILLE 704-664-5281

IMPROVEMENT PERMIT / AUTHORIZATION TO CONSTRUCT / OPERATION PERMIT / EXISTING SYSTEM INSPECTION

PERMIT# 087217 PIN# 4760615830 ~~4760-61-4958~~ DATE 2/1/2000

OWNER OR CONTRACTOR Oakwood Homes Richard PHONE: Business 528-4516 Home

ADDRESS 1042 Charlotte Hwy Troutman, NC 28166

LOCATION Hwy 115 N TR Shinnville Rd just past Satellite Dr & before Brawley Rd on left

SUBDIVISION — BLOCK / SECTION — LOT — LOT AREA 1.8 Acres SITE CLASS. PS DESIGN FLOW 480gpd L.T.A.R. .4 (Saprolite)

Septic Tank: 1000 Gallons; STB 794 Date 3/4/99

Pump Tank: 1000 Gallons; PT 27 Date 1/22/00

Pump Make: Hydromatic Model Site Saver Serial No. 12/0/99

Nitrification Field: No Fields 1 Square Feet 900 Linear Feet 300

No Lines 3 Trench Width 36" Max Trench Bottom Depth 36" Gravel Depth N/A

[X] New System [ ] Repair System Type: I, II, III, IV, V, VI

System Description: Pump (PM) 25% Reduction

Repair System Description: Pump - Innovative

Maintenance Agreement Required: [ ] Yes [X] No

[ ] House/Mod. Home [X] Mobile Home [ ] Business [ ] Other

No. Bedrooms 4 No. Bathrooms 2 No. Employees

[ ] Slab [X] Crawl Space [ ] Basement w/plumbing [ ] Basement wo/plumbing


Water Supply: [X] Individual [ ] Public [ ] Community

Comments:/Conditions: ~~X~~Must keep 100' separation between Septic System (Tanks & lines) & any well.


Comments:/Conditions: Keep Septic System at least 5' from house & 10' from PL

(Lines / Tanks)

INITIAL SITE SKETCH

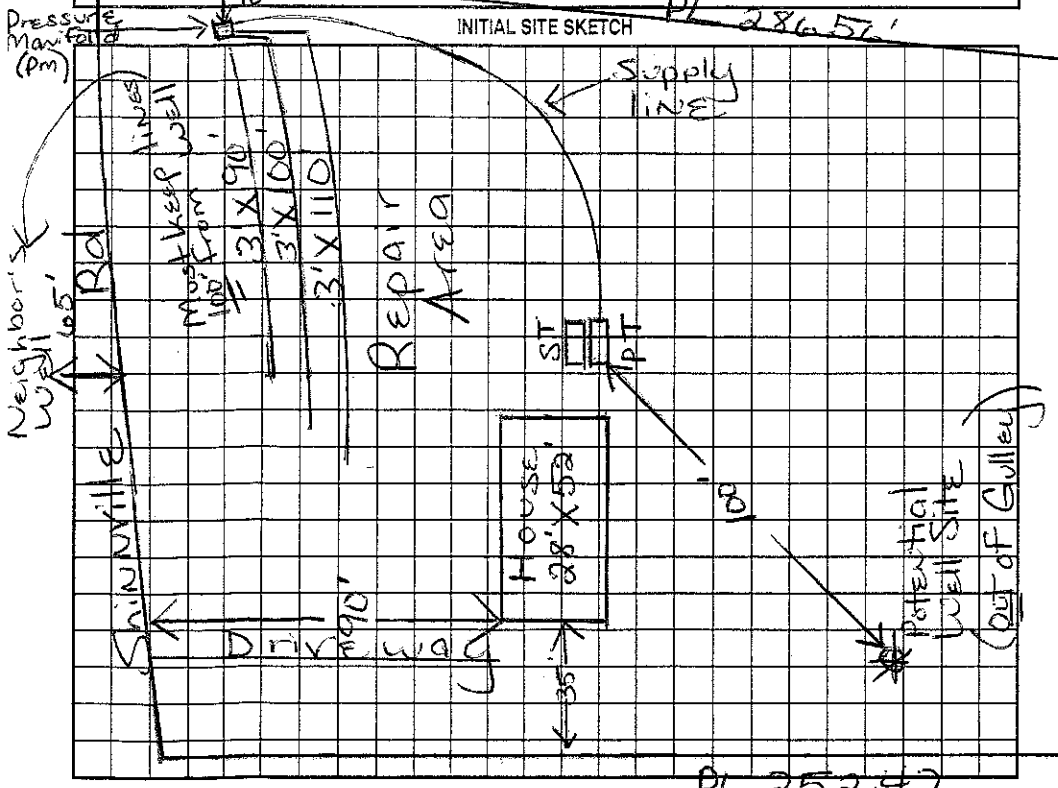

AS BUILT SKETCH

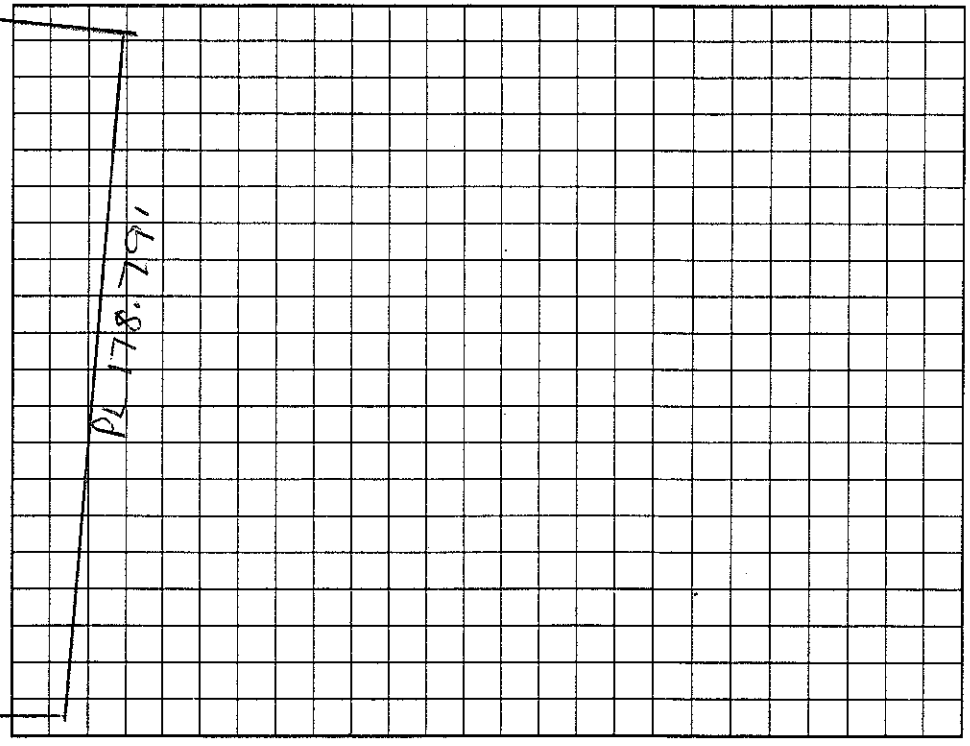

Permit can be suspended or revoked if any false information is supplied toward securing the permit/any unauthorized changes are made to the site/any unauthorized changes are made in the installation of the system. Improvement Permit with plat valid without expiration. Improvement Permit with site plan valid for sixty months. Authorization to Construct is valid for a period equal to that of Improvement Permit – not to exceed sixty months.

Signed: Jane Oak date 2-4-00 Installed by: Marty Tucker

Improvement Permit by: Maria H. Dotson RS date 2/1/2000 Operation Permit by: Wesley Sparks RS. date 5/10/00

Authorization to Construct by: Maria H. Dotson RS date 2/1/2000 Existing System Inspection by: date

HEALTH DEPT. COPY: WHITE OWNER COPY (FINAL): YELLOW OWNER COPY (INITIAL): PINK