IREDELL COUNTY HEALTH DEPARTMENT

STATESVILLE 704-878-5305 MOORESVILLE 704-664-5281

4760626141

IMPROVEMENT PERMIT / CERTIFICATE OF COMPLETION / OPERATION PERMIT / EXISTING SYSTEM INSPECTION

PROPERTY DESCRIPTION NO. 16707 DATE 7/27/93 TAX MAP NO. 4H A 28

OWNER OR CONTRACTOR JAMES H SANFORD PHONE: Business _____ Home 664-3562

ADDRESS PO BOX 337 MT MOURNE, NC. 28123

LOCATION SHINNVILLE RD. ON L JUST BEFORE BRAWLEY RD.

SUBDIVISION — BLOCK / SECTION — LOT — LOT AREA ~4.9AC SITE CLASS. P L.T.A.R. 25 3

Water Supply: ☑ Individual ☐ Community ☐ Public

Septic Tank: 1000 Gallons; STB 825 Date 7/16/93

Pump Tank: _____ Gallons; PT _____ Date _____

Nitrification Field: No. Fields 1 Square Feet 1200 Linear Feet 400

No. Lines 4 Trench Width 36" Trench Depth 36" Gravel Depth 12"

☑ New System ☐ Repair System Type: I, ☑ II, IV, V, VI

System Description: CONV - GRAVITY

Repair System Description: CONV - GRAVITY

Maintenance Agreement Required: ☐ Yes ☑ No

☑ House/Mod. Home No. Bedrooms 3 Garbage Disposal: ☐ Yes ☑ No

☐ Mobile Home No. Bathrooms 2 Auto. Dishwasher: ☑ Yes ☐ No


☐ Business No. Employees _____ Auto. Washing Machine: ☑ Yes ☐ No

☐ Other _____ Other _____

☐ Slab ☐ Crawl Space ☐ Basement w/plumbing ☑ Basement wo/plumbing

Comments TRENCHES NO DEEPER THAN 36" DEEP
LINES ON CONTOUR IN DIRECTION SHOWN HERE

INITIAL SITE SKETCH

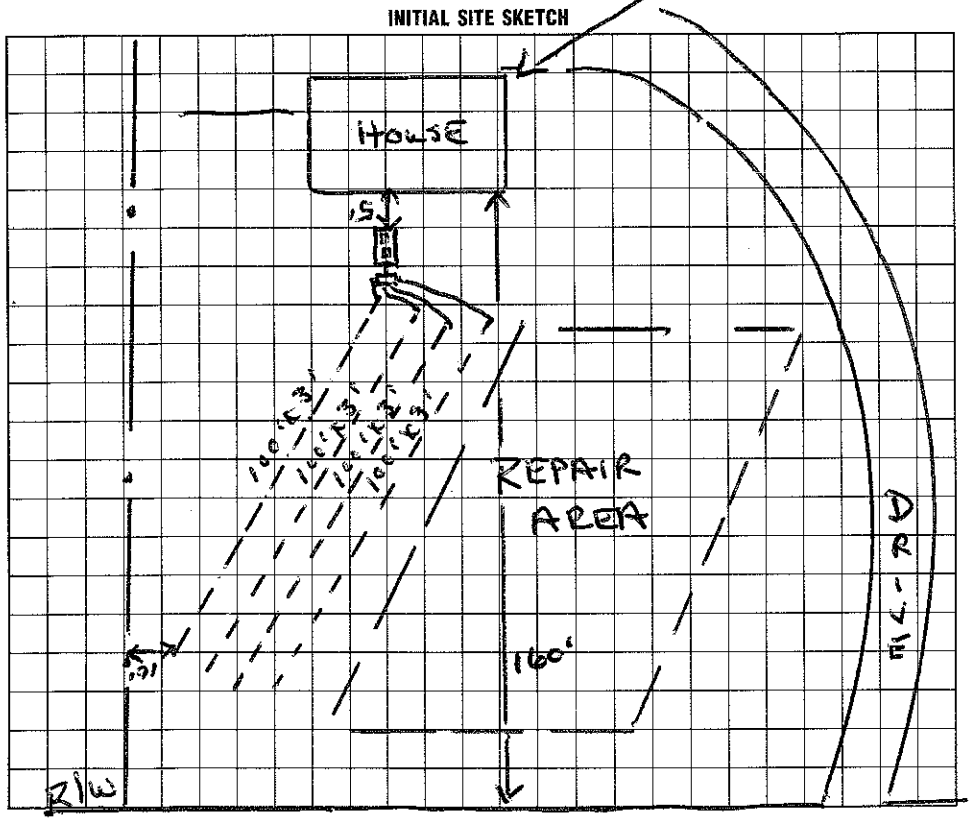

AS BUILT SKETCH

Installed as shown on Imp. Permit.

I understand that this permit can be suspended or revoked if any false information is supplied toward securing the permit/any unauthorized changes are made to the site/any unauthorized changes are made in the installation of the system. Improvement Permit is valid for 60 months from date of issuance.

Signed MOORESVILLE RT 3 SHINNVILLE RD James H Sanford

Improvement Permit by: Wesley Sparks R.S. date 7/27/93

Existing System Inspection by: _____ date _____

Installed by: Jim Sanford.

Certificate of Completion by: Wesley Sparks R.S. date 11/12/93

Operation Permit by: _____ date _____

HEALTH DEPT. COPY: WHITE INSPECTION COPY (FINAL): GREEN OWNER COPY (FINAL): YELLOW INSPECTION COPY (INITIAL): PINK OWNER COPY (INITIAL): GOLD