4760640927

IREDELL COUNTY HEALTH DEPARTMENT

STATESVILLE 704-878-5305 MOORESVILLE 704-664-5281

IMPROVEMENT PERMIT / CERTIFICATE OF COMPLETION / OPERATION PERMIT / EXISTING SYSTEM INSPECTION

PROPERTY DESCRIPTION NO. _____ DATE Dec 1, '95 TAX MAP NO. _____ Watershed: ☐ Yes ☐ No

OWNER OR CONTRACTOR RC Brawley PHONE: Business _____ Home _____

ADDRESS 574 Brawley Rd Cleveland

LOCATION 115-21 N to Statesville Rd TL Brawley Rd X Creek 3rd house on left

SUBDIVISION _____ BLOCK / SECTION _____ LOT _____ LOT AREA 1 Acre SITE CLASS. _____ DESIGN FLOW 240 gpd L.T.A.R. 0.3-0.4

Septic Tank: EXISTING Gallons; STB _____ Date _____

Pump Tank: _____ Gallons; PT _____ Date _____

Pump Make: _____ Model _____ Serial No. _____

Nitrification Field: No Fields 1 Square Feet 540+ Linear Feet 180+

No Lines 2 @ 90' Trench Width 36" Max Trench Bottom Depth 36" Gravel Depth 12"

☐ New System ☑ Repair System Type: I, (II) III, IV, V, VI

System Description: _____

Repair System Description: grav. conventional

Maintenance Agreement Required: ☐ Yes ☑ No

☑ House/Mod. Home No. Bedrooms 2

☐ Mobile Home No. Bathrooms 1

☐ Business No. Employees ____

☐ Other _____


☐ Slab ☑ Crawl Space ☐ Basement w/plumbing ☐ Basement wo/plumbing

Water Supply: ☑ Individual ☐ Community ☐ Public

Comments: Disconnect old line, use approx 20' of 4" to new tee w/spread levelers where shown & check tank for tee.

Comments: Installed as drawn.

INITIAL SITE SKETCH

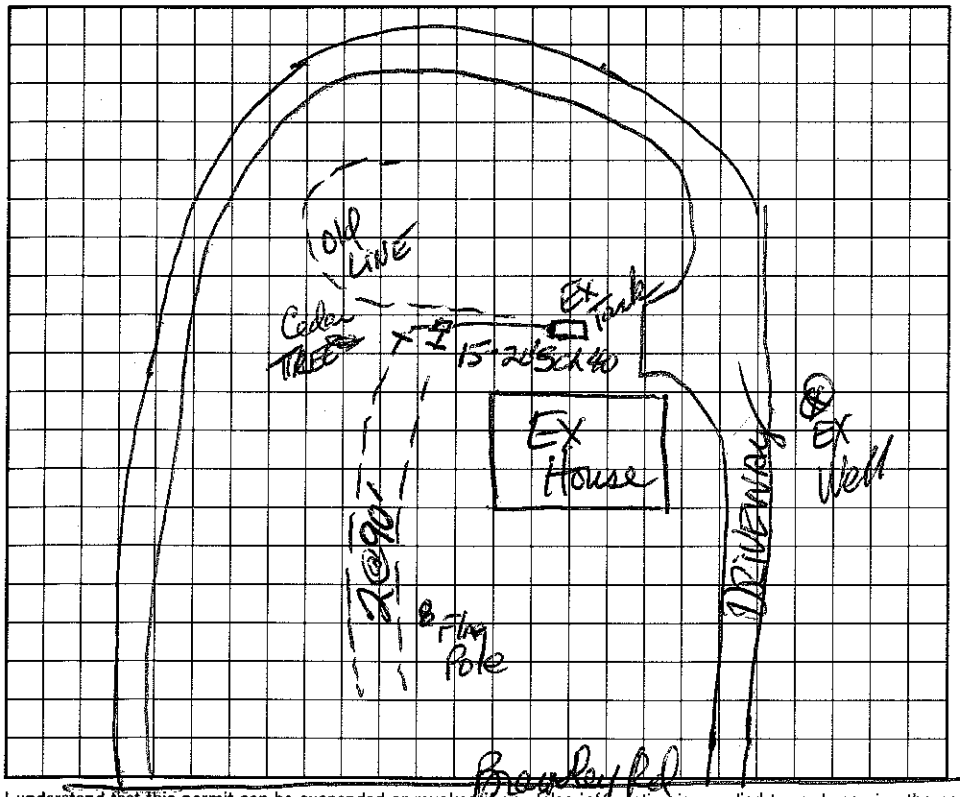

AS BUILT SKETCH

I understand that this permit can be suspended or revoked if any false information is supplied toward securing the permit/any unauthorized changes are made to the site/any unauthorized changes are made in the installation of the system.

Signed: X R.C. Brawley Installed by: Julian Bowles

Improvement Permit by: [illegible] RS date 12-1-95 Certificate of Completion by: _____ date _____

Existing System Inspection by: [illegible] RS date 12-1-95 Operation Permit by: Wesley Sparks RS date 12/14/95

HEALTH DEPT. COPY: WHITE INSPECTION COPY (FINAL): GREEN OWNER COPY (FINAL): YELLOW INSPECTION COPY (INITIAL): PINK OWNER COPY (INITIAL): GOLD