IREDELL COUNTY HEALTH DEPARTMENT - *ENVIRONMENTAL HEALTH* ☑ STATESVILLE OFFICE 704-878-5305 ☐ MOORESVILLE OFFICE 704-664-5281

IMPROVEMENT PERMIT / AUTHORIZATION TO CONSTRUCT / OPERATION PERMIT / EXISTING SYSTEM INSPECTION

PERMIT # 172980 PIN # 4760641142 DATE 6-8-12

OWNER Carrie Taylor APPLICANT: Same PHONE: Home/Cell # 704-701-4355 Business # N/A

SITE ADDRESS Brawley Rd. Cleveland NC OWNER / APPLICANT ADDRESS 117 East Morehouse Ave Mooresville NC

SITE DIRECTIONS Ostwalt Amity Rd to Brawley Rd. Property on right

SUBDIVISION N/A BLOCK / SECTION N/A LOT # N/A LOT AREA 9.677 acres DESIGN FLOW 480 gpd L.T.A.R. 0.25

Septic Tank 1000 Gallons: STB 760 Date 9-30
Pump Tank Gallons: P.T. Date
Pump Make Model Serial #
No. Nitrification Fields: 1 No. Lines 5 Linear Feet 640
Trench Width 36" Max. Trench Bottom Depth 36" Gravel Depth 12"

☑ New System ☐ Repair ☐ Expansion System Type I (II) III IV V VI
System Description: Conventional - gravity
Repair System Description: 25% Reduction
Maintenance Agreement Required ☐ YES ☑ NO
☑ GRAVITY ☐ PRESSURE

☑ Residence No. Bedrooms 4
☐ Business No. Persons
☐ Other No. Employees
☐ Slab ☐ Crawl Space
☑ Basement w/plumbing ☐ Basement w/o plumbing


Water Supply
☑ Private
☐ Public
☐ Community

Comments / Conditions: Install a conventional system on contour w/ serial distribution; An Accepted system may also be installed.


Quick 4 Chambers Installed
Red Polylok filter installed

1 112'
2 120'
3 128'
4 120

INITIAL SITE SKETCH

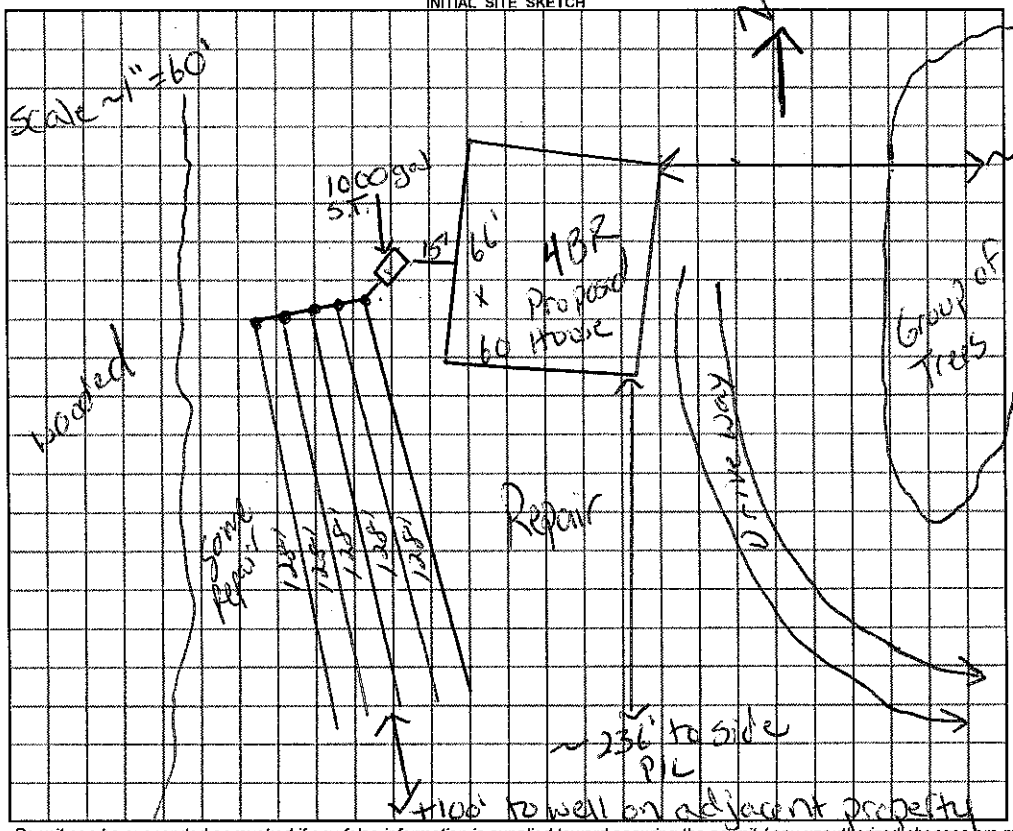

AS BUILT SKETCH

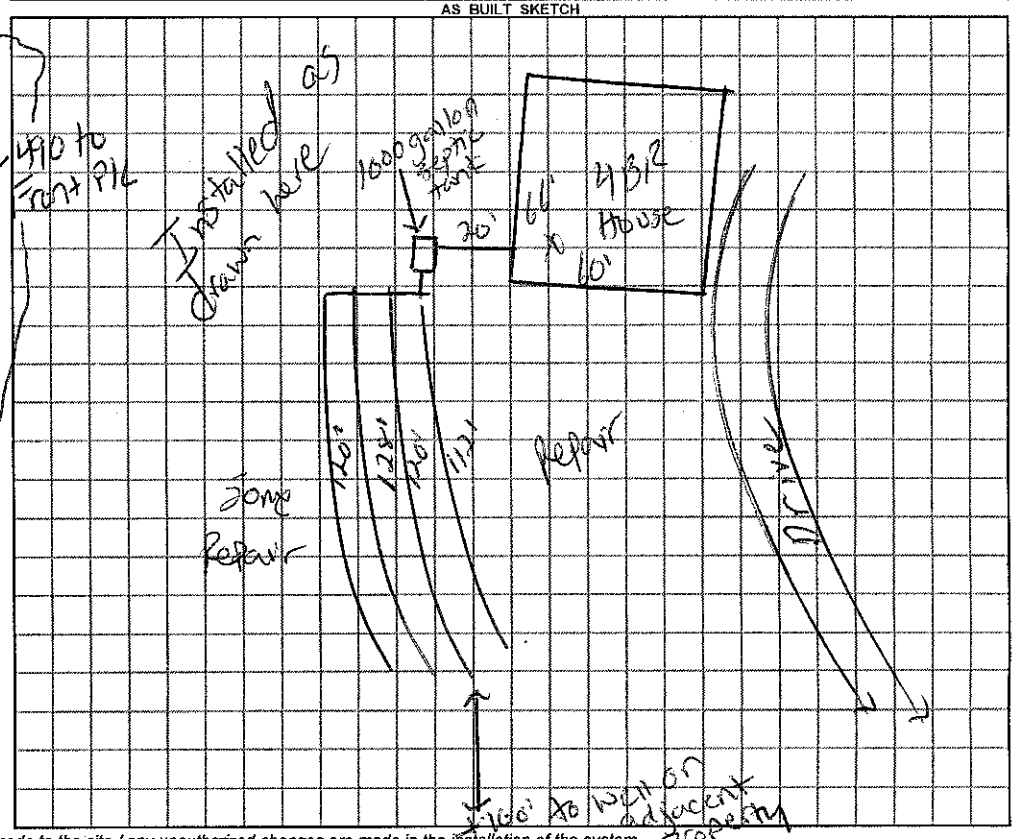

Permit can be suspended or revoked if any false information is supplied toward securing the permit / any unauthorized changes are made to the site / any unauthorized changes are made in the installation of the system.

☐ ***IMPROVEMENT PERMIT*** with plat valid without expiration.
☑ ***IMPROVEMENT PERMIT*** with plat ~~valid without expiration~~ site plan valid 60 mo.
☑ ***AUTHORIZATION TO CONSTRUCT*** valid for period equal to IMPROVEMENT PERMIT--not to exceed 60 mo.

Owner / Applicant Signature: Carrie Taylor Date 6/12/12
IMPROVEMENT PERMIT by: Justin Henderson REHS Date 6-8-12
AUTHORIZATION TO CONSTRUCT by: Justin Henderson REHS Date 6-9-12

Installed by: James O'Daniel Specialty Septic
OPERATION PERMIT by: Justin Henderson REHS Date 9-27-12
Existing System Inspected by: REHS Date

YOU SHOULD CONTACT A LOCATOR SERVICE PRIOR TO ANY EXCAVATION

White Copy – Environmental Health YELLOW COPY (Final) Owner / Applicant PINK COPY (Initial) Owner / Applicant