IREDELL COUNTY HEALTH DEPARTMENT

STATESVILLE 704-878-5305 MOORESVILLE 704-664-5281

IMPROVEMENT PERMIT / AUTHORIZATION TO CONSTRUCT / OPERATION PERMIT / EXISTING SYSTEM INSPECTION

PERMIT # 160867 PIN # 4760666O209 DATE 6-11-2010

OWNER or APPLICANT James Whittington PHONE: Business 7046966219 Home: 704 528-6492

OWNER or APPLICANT ADDRESS 515 Brawley Rd Cleveland, NC

LOCATION / DIRECTIONS Hwy 115 N TR Shinnville Rd ~ 6 mi TL Brawley Rd 1 mile on right

SUBDIVISION Strawberry Hill Acre BLOCK / SECTION LOT # 6 LOT AREA DESIGN FLOW 360gpd L.T.A.R. .3

EXIST

Septic Tank 1000 Gallons: STB Date

Pump Tank Gallons: PT Date

Pump Make Model Serial #

Nitrification Field No Fields 1 No Lines 4 Linear Feet 300

Trench Width 36" Max. Trench Bottom Depth 24 Gravel Depth N/A

☒ New System ☐ Repair ☐ Expansion System Type I (II) III IV V VI

System Description: Gravity -25% Reduction

Repair System Description: LP Panel

Maintenance Agreement Required ☐ YES ☒ NO

☒ GRAVITY ☐ PRESSURE

☒ Residence No. Bedrooms 3

☐ Business No. Persons

☐ Other No. Employees

☐ Slab ☐ Crawl Space


☐ Basement w/plumbing ☐ Basement w/o plumbing

Water Supply: ☒ Private ☐ Public ☐ Community

Comments / Conditions Existing Septic System appears to be functioning okay at time of inspection.

Comments / Conditions Must keep footers / foundation of deck at least 5FT from Septic System.

INITIAL SITE SKETCH

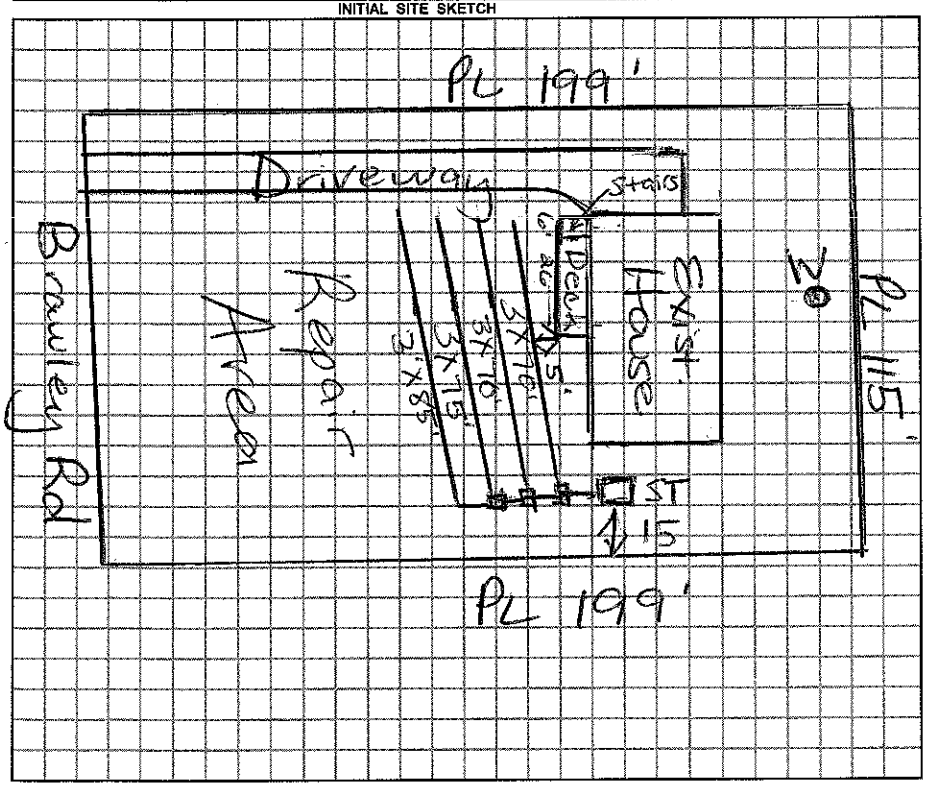

AS BUILT SKETCH

Permit can be suspended or revoked if any false information is supplied toward securing the permit / any unauthorized changes are made to the site / any unauthorized changes are made in the installation of the system.

☐ *IMPROVEMENT PERMIT w / plat valid without expiration.* ☐ *IMPROVEMENT PERMIT w / site plan valid for 60 mos.* ☐ *AUTHORIZATION TO CONSTRUCT valid for period equal to IMPROVEMENT PERMIT-not to exceed 60 mo.*

Owner / Applicant Signature: James R Whittington Date 6-11-10

Improvement Permit by: Date

Authorization to Construct by: Date

YOU SHOULD CONTACT A LOCATOR SERVICE PRIOR TO ANY EXCAVATION.

Installed by:

Operation Permit by: Date:

Existing System Inspected by: Marie H Robertson REHS Date: 6/11/2010

WHITE COPY Environmental Health YELLOW COPY (Final) Owner / Applicant PINK COPY (Initial) Owner / Applicant