IREDELL COUNTY HEALTH DEPARTMENT

STATESVILLE 704-878-5305 MOORESVILLE 704-664-5281

IMPROVEMENT PERMIT / AUTHORIZATION TO CONSTRUCT / OPERATION PERMIT / EXISTING SYSTEM INSPECTION

DATE 1-6-06

PERMIT# 133189 PIN# [redacted] 4760660209

OWNER OR APPLICANT Pinnacle Housing Group PHONE: Business 704-895-4622 Home

ADDRESS 16315-F Northcross Dr Huntersville 28078

LOCATION Hwy 115 N TR Shinnville Rd TL Brawley Rd on right

SUBDIVISION Strawberry Hill Ac BLOCK / SECTION LOT 6 LOT AREA SITE CLASS. PS DESIGN FLOW 360gpd L.T.A.R. .3 gpd/ft²

Septic Tank: 1000 Gallons: STB 1012 Date 6-14-05

Pump Tank: Gallons: PT Date

Pump Make: Model Serial No.

Nitrification Field: No Fields 1 Square Feet Linear Feet 300

No Lines 4 Trench Width 36" Max Trench Bottom Depth 24"

☒ New System ☐ Repair ☐ Expansion System Type: I ☐ II III IV V VI

System Description: 25% reduction gravity

Repair System Description: LP Panel

Maintenance Agreement Required: ☐ Yes ☒ No

☒ House/Mod. Home ☐ Mobile Home ☐ Business ☐ Other

No. Bedrooms 3 No. Persons No. Employees

Water Supply: ☒ Individual ☐ Public ☐ Community


Gravel Depth N/A ☒ Gravity ☐ Pressure ☐ Slab ☒ Crawl Space ☐ Basement w/plumbing ☐ Basement wo/plumbing

Comments:/Conditions: May Trench Bottom 24"

Comments:/Conditions: Yellow tuf-tite filter
Septic tank w/marker
Quick-4 Infiltrator

1" = 50'

INITIAL SITE SKETCH

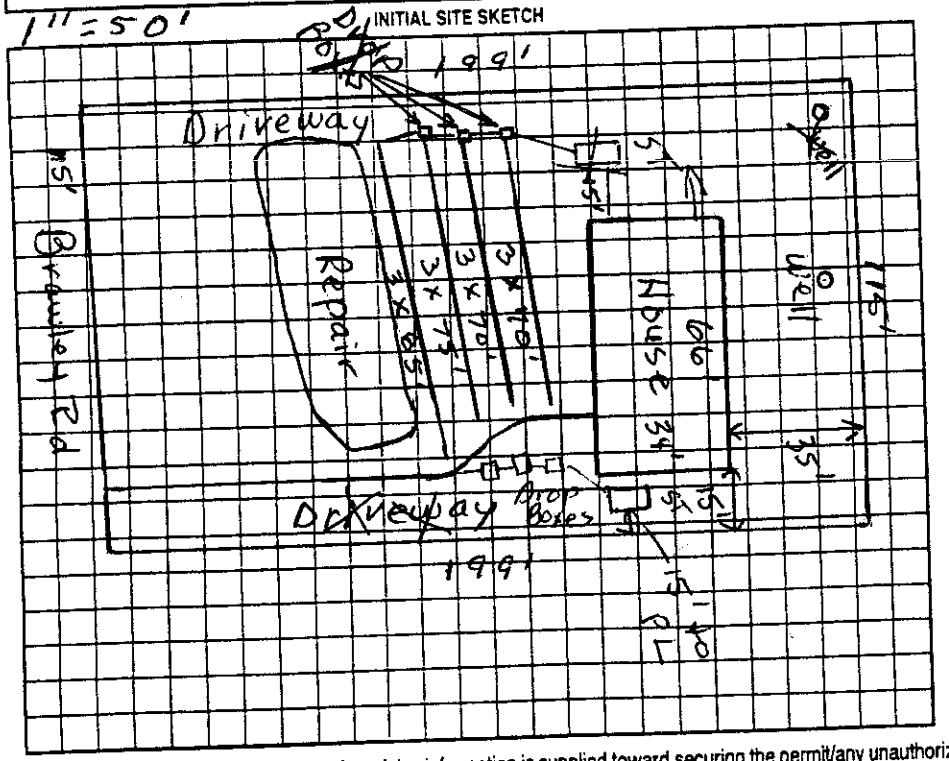

AS BUILT SKETCH

Line 1 74'
Line 2 78'
Line 3 78'
Line 4 78'

Changes in initial site sketch:
3 Drop boxes switched to other side
Driveway switched to other side.
Tank switched to other side
Lines installed as listed above
House shifted to left

Permit can be suspended or revoked if any false information is supplied toward securing the permit/any unauthorized changes are made to the site/any unauthorized changes are made in the installation of the system. Improvement Permit with plat valid without expiration ☐ Improvement Permit with site plan valid for sixty months ☒ Authorization to Construct is valid for a period equal to that of Improvement Permit – not to exceed sixty months.

Signed: Tawana Hollifield date 1-11-06

Improvement Permit by: Judy Melville date 1-6-06

Authorization to Construct by: Judy Melville date 1-6-06

Installed by: A-1 Backhoe

Operation Permit by: Judy Melville date 2-24-06

Existing System Inspection by: date

HEALTH DEPT. COPY: WHITE OWNER COPY (FINAL): YELLOW OWNER COPY (INITIAL): PINK