IREDELL COUNTY HEALTH DEPARTMENT

Statesville Office (704) 878-5305 Mooresville Office (704) 660-3625 PERMIT # 180486

IMPROVEMENT PERMIT / AUTHORIZATION TO CONSTRUCT / OPERATION PERMIT / EXISTING SYSTEM

PIN # 4760 67 4048

APPLICANT: Elizabeth Turmelle APPLICANT ADDRESS: 141 Strawberry Hill Ln

SITE ADDRESS: 141 Strawberry Hill Lane, Cleveland NC 27013 PHONE: 704-746-7639 ALT. PHONE:

SITE DIRECTIONS: 21 N TR Shinnville TL Brawley Rd TR Strawberry Hill on left

SUBDIVISION: SECTION: LOT # LOT AREA: DESIGN FLOW: L.T.A.R.:

Septic Tank Existing (gal) STB Date
Pump Tank (gal) PT Date
Pump Make Model Serial #
Nitrification Fields # Lines Linear Ft:
Trench Width Max. Trench Bottom Depth Gravel Depth

☐ New System ☐ Repair ☐ Expansion System Type: I (II) III IV V VI
System Description: Existing conventional
Repair System Description:
Maintenance Agreement Required: ☐ YES ☐ NO ☐ GRAVITY ☐ PRESSURE

☐ Residence No. Bedrooms
☐ Business No. Persons
☒ Other * No. Employees
☐ Slab ☐ Crawl Space
☐ Basement w/plumbing ☐ Basement w/o plumbing

Water Supply: ☒ Private ☐ Public ☐ Community


Comments / Conditions:

middle septic line was full of liquid. Lowest line was nearly dry. An adjustment to allow more equal distribution at the lower 2 lines would be beneficial.


* Above ground pool

original septic permit issued 1986

INITIAL SITE SKETCH

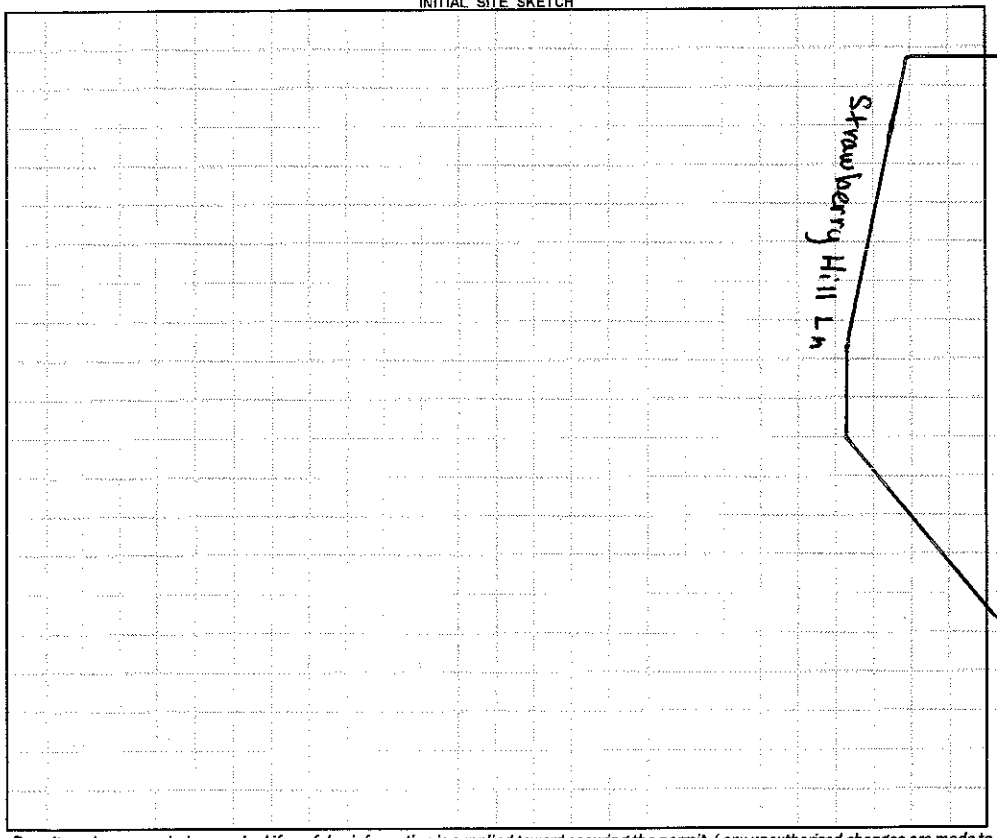

AS BUILT SKETCH

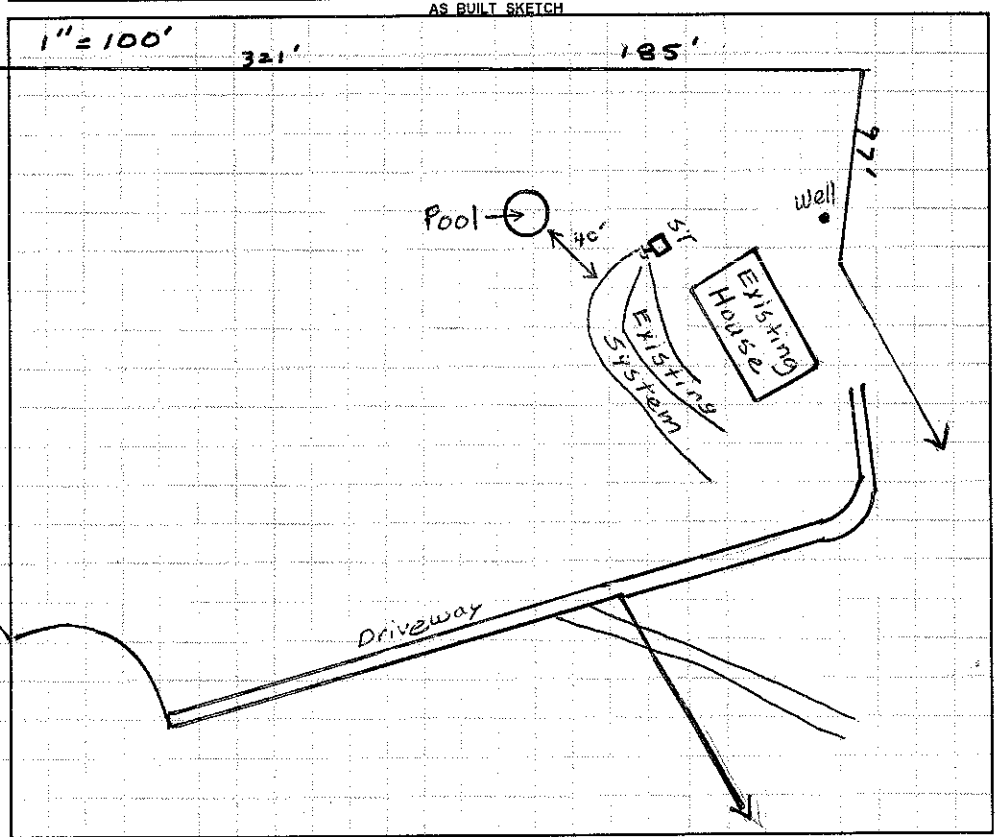

Permit can be suspended or revoked if any false information is supplied toward securing the permit / any unauthorized changes are made to the site / any unauthorized changes are made in the installation of the system. **CONTACT A LOCATOR SERVICE PRIOR TO ANY EXCAVATION**

☐ **IMPROVEMENT PERMIT *with plat*** *valid without expiration.* ☐ **IMPROVEMENT PERMIT *with site plan*** *valid for 60 mos.* ☐ **AUTHORIZATION TO CONSTRUCT** *valid for period equal to IMPROVEMENT PERMIT--not to exceed 60 mo.*

Owner / Applicant Signature: Elizabeth Y. Turmelle Date: 9-27-13 Installed by:

IMPROVEMENT PERMIT by: Date: OPERATION PERMIT by: Date:

AUTHORIZATION TO CONSTRUCT by: Date: Existing System Inspected by: Judy Melville Date: 9-23-13

Health Dept. Copy - WHITE Applicant (Final Approval) - YELLOW Applicant (Conditional Approval) - PINK