704-664-2881 (1) 9[illegible]

IREDELL COUNTY HEALTH DEPARTMENT Authorization to Construct

STATESVILLE 704-878-5305 MOORESVILLE 704-664-5281

IMPROVEMENT PERMIT / CERTIFICATE OF COMPLETION / OPERATION PERMIT / EXISTING SYSTEM INSPECTION

PROPERTY DESCRIPTION NO. 25936 DATE 1/23/97 TAX MAP NO. 4669 79 5902 Watershed: ☐ Yes ☒ No

OWNER OR CONTRACTOR Stephen Roy PHONE: Business _____ Home 663-2951

ADDRESS 257 Indian Pond Lane Mooresville, NC. 28115

LOCATION I-5 N TR Shinnville Rd. TR Winthrow Creek & creek to pond TR [illegible] follow down follow down [illegible]

SUBDIVISION 4H B 74 BLOCK / SECTION — LOT — LOT AREA 5± Ac SITE CLASS. PS DESIGN FLOW 360 L.T.A.R. .3

Septic Tank: 1000 Gallons; STB 794 Date 11-8-96
Pump Tank: _____ Gallons; PT _____ Date _____
Pump Make: _____ Model _____ Serial No. _____
Nitrification Field: No Fields 1 Square Feet 1260 Linear Feet 400
No Lines 3 Trench Width 36" Max Trench Bottom Depth 36" Gravel Depth 12"

☒ New System ☐ Repair System Type: I, II, III, IV, V, VI
System Description: Conventional - Low Pressure Pipe
Repair System Description: _____
Maintenance Agreement Required: ☐ Yes ☒ No


☒ House/Mod. Home No. Bedrooms 3
☐ Mobile Home No. Bathrooms 3
☐ Business No. Employees _____
☐ Other _____
☐ Slab ☐ Crawl Space ☒ Basement w/plumbing ☐ Basement w/o plumbing

Water Supply:
☒ Individual
☐ Community
☐ Public


Comments: Speed Levelers Required
No P/L's
CLOSE

Comments:

ORIGINAL SITE SKETCH

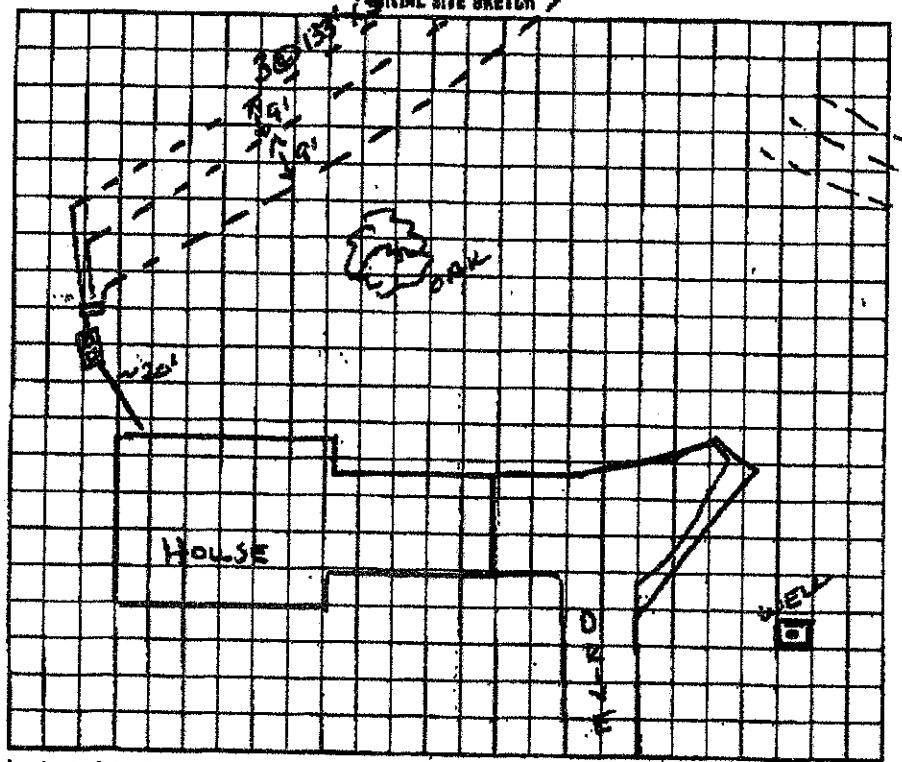

AS BUILT SKETCH

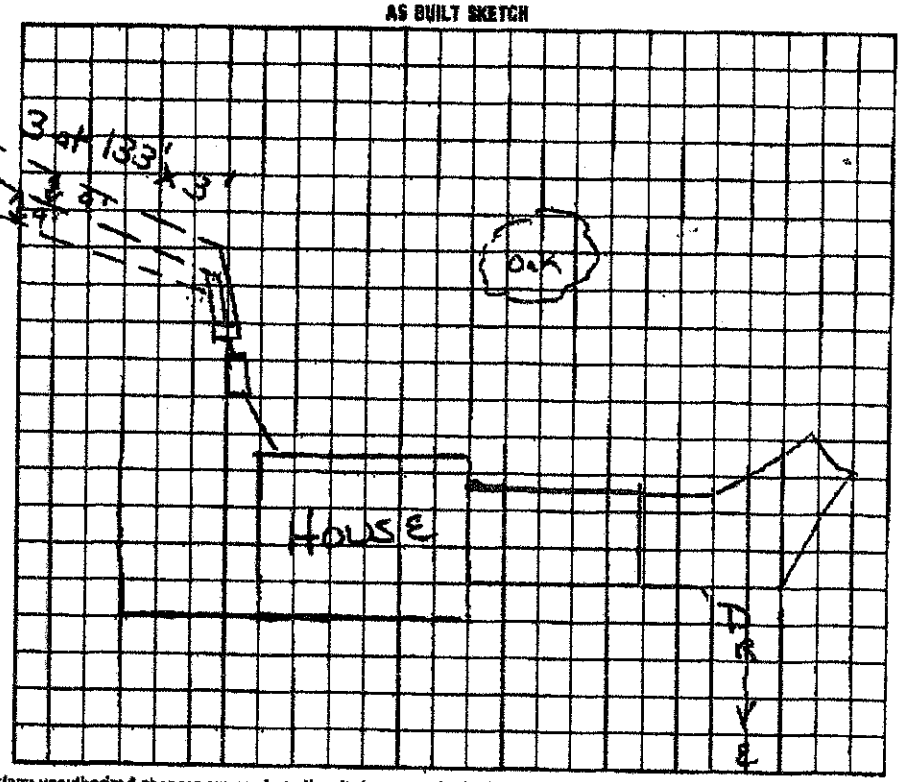

I understand that this permit can be suspended or revoked if any false information is supplied toward securing the permit/any unauthorized changes are made to the site/any unauthorized changes are made in the installation of the system. Improvement Permit is valid for 60 months from date of issuance.

Signed: * Russell Nelson

Improvement Permit by: Wesley Sparks R.S. date 1/23/97

Existing System Inspection by: Wesley Sparks R.S. date 1/23/97

Installed by: Tim Ammons

Certificate of Completion by: Marie H. Dotson date 5/7/97

Operation Permit by: Marie H. Dotson date 5/7/97

PAGE 01

04/28/2008 12:22 7046623239