(138506 / 138505)

4760-71-0694

IREDELL COUNTY HEALTH DEPARTMENT

STATESVILLE 704-878-5305 MOORESVILLE 704-664-5281

IMPROVEMENT PERMIT / AUTHORIZATION TO CONSTRUCT / OPERATION PERMIT / EXISTING SYSTEM INSPECTION

PERMIT# ~~138468~~ PIN# ~~4760 71 0895~~ 4760 71 1443.001 DATE 8/16/06

OWNER OR APPLICANT Dirty Mo Cars LLC PHONE: Business 704-236-9195 Home

ADDRESS PO Box 3301 Mooresville, NC. 28115

LOCATION 115 N TR Shinnville Rd. TR asphalt drive before main entrance on (R) before house

SUBDIVISION Dirty Mo BLOCK / SECTION LOT NA LOT AREA .71 Ac SITE CLASS. RS DESIGN FLOW 480 L.T.A.R. .3

Septic Tank: 1500 Gallons: STB 338 Date 8/11/06
Pump Tank: Gallons; PT Date
Pump Make: Model Serial No.
Nitrification Field: No Fields 1 Square Feet 1200 Linear Feet 400
No Lines 3@133' Trench Width 3' Max Trench Bottom Depth 3'

☒ New System ☐ Repair ☐ Expansion System Type: I II (III) IV V VI
System Description: Gravity - 25% Reduced
Repair System Description: Pressure 25% Reduced
Maintenance Agreement Required: ☐ Yes ☒ No

Gravel Depth NA ☒ Gravity ☐ Pressure ☐ Slab ☒ Crawl Space ☐ Basement w/plumbing ☐ Basement wo/plumbing


☒ House/Mod. Home No. Bedrooms 4
☐ Mobile Home No. Persons
☐ Business No. Employees
☐ Other

Water Supply: ☒ Individual ☐ Public ☐ Community

Comments:/Conditions: Install on contour in area shown

Comments:/Conditions: 2 infiltrators installed

INITIAL SITE SKETCH

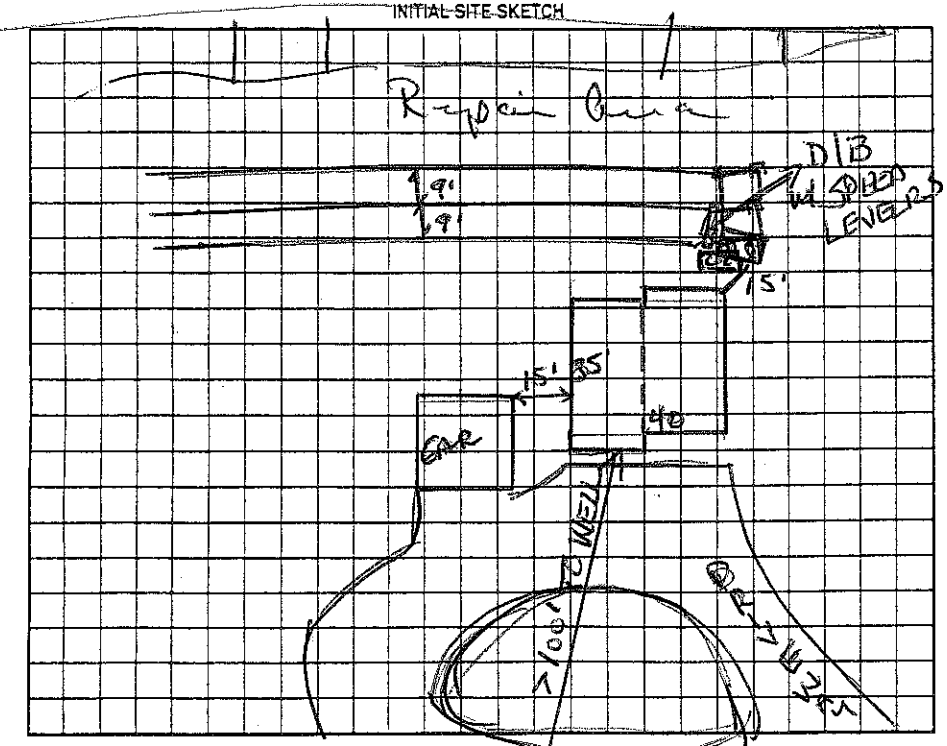

AS BUILT SKETCH

Permit can be suspended or revoked if any false information is supplied toward securing the permit/any unauthorized changes are made to the site/any unauthorized changes are made in the installation of the system. Improvement Permit with plat valid without expiration ☐ Improvement Permit with site plan valid for sixty months ☐ Authorization to Construct is valid for a period equal to that of Improvement Permit – not to exceed sixty months.

Signed: John Eisele date 8/16/06 Installed by: Curt Denning

Improvement Permit by: Wesley Sparks R.S. date 8/16/06 Operation Permit by: Wesley Sparks R.S. date 12/8/06

Authorization to Construct by: Wesley Sparks RS date 8/16/06 Existing System Inspection by: date

HEALTH DEPT. COPY: WHITE OWNER COPY (FINAL): YELLOW OWNER COPY (INITIAL): PINK