Paid 550.00

1100

IREDELL COUNTY HEALTH DEPARTMENT

STATESVILLE 704-878-5305 MOORESVILLE 704-664-5281

IMPROVEMENT PERMIT / AUTHORIZATION TO CONSTRUCT / OPERATION PERMIT / EXISTING SYSTEM INSPECTION

PERMIT# 136068/136068 PIN# ~~4760-91-0895~~ 4760710735.000 DATE 6/22/06

OWNER OR APPLICANT Dirty Mo Auto LLC PHONE: Business Rader - 704-236-9195 Home

ADDRESS PO Box 330 Mooresville, NC. 28115

LOCATION 115-21 N TR Shinnville Rd. on (R) just before Brawley Rd. on (L)

SUBDIVISION ~~Lot~~ Dirty Moe Acres BLOCK / SECTION LOT 1 LOT AREA .74 AC SITE CLASS. PS DESIGN FLOW 480 L.T.A.R. .3

Septic Tank: EXISTING Gallons; STB EXIST Date

Pump Tank: 1000 Gallons; PT 27 Date 8-1-06

Pump Make Goulds Model WE03 11M Serial No.

Nitrification Field: No Fields 1 Square Feet 1200 Linear Feet 400

No Lines 4@100' Trench Width 3' Max Trench Bottom Depth 3'

[X] New System [ ] Repair [ ] Expansion System Type: I II III IV V VI

System Description: Pres Manifold - 25% Reduced

Repair System Description: Sidney above addition

Maintenance Agreement Required: [ ] Yes [X] No

[ ] House/Mod. Home No. Bedrooms 4

[ ] Mobile Home No. Persons

[ ] Business No. Employees

[X] Other 480 / DUPLEX

Water Supply: [X] Individual [ ] Public [ ] Community


Gravel Depth No [ ] Gravity [X] Pressure [ ] Slab [ ] Crawl Space [ ] Basement w/plumbing [ ] Basement wo/plumbing

Comments:/Conditions: R/W SHINNVILLE RD. Check PT, lines & pressure 9/24/06

Comments:/Conditions:


1" = 50'

INITIAL SITE SKETCH

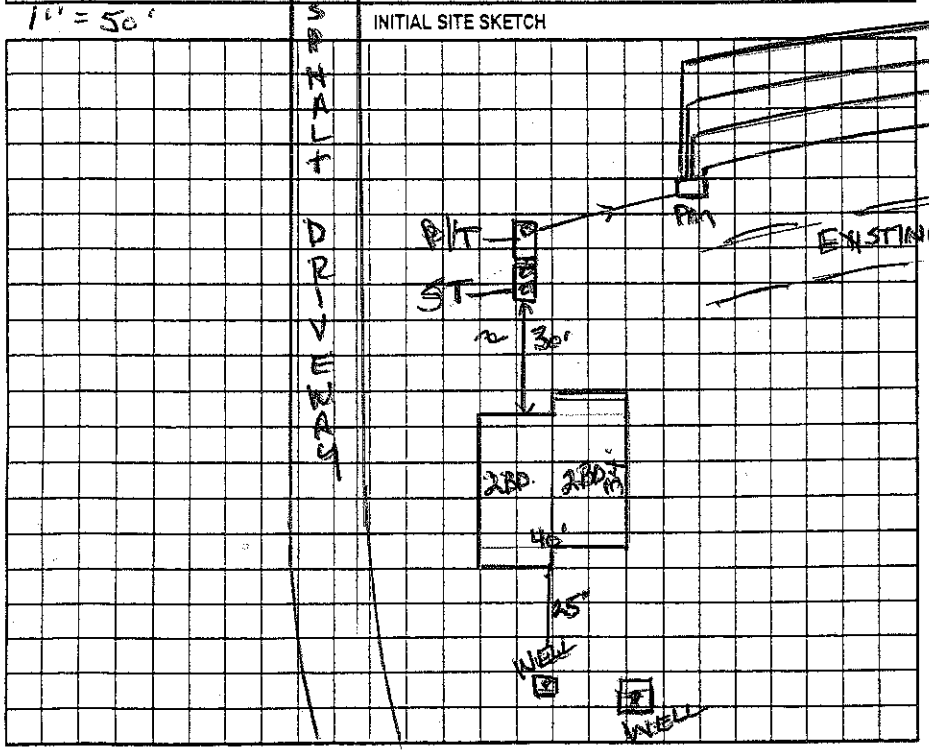

AS BUILT SKETCH

Installed Quick 4 as Shown

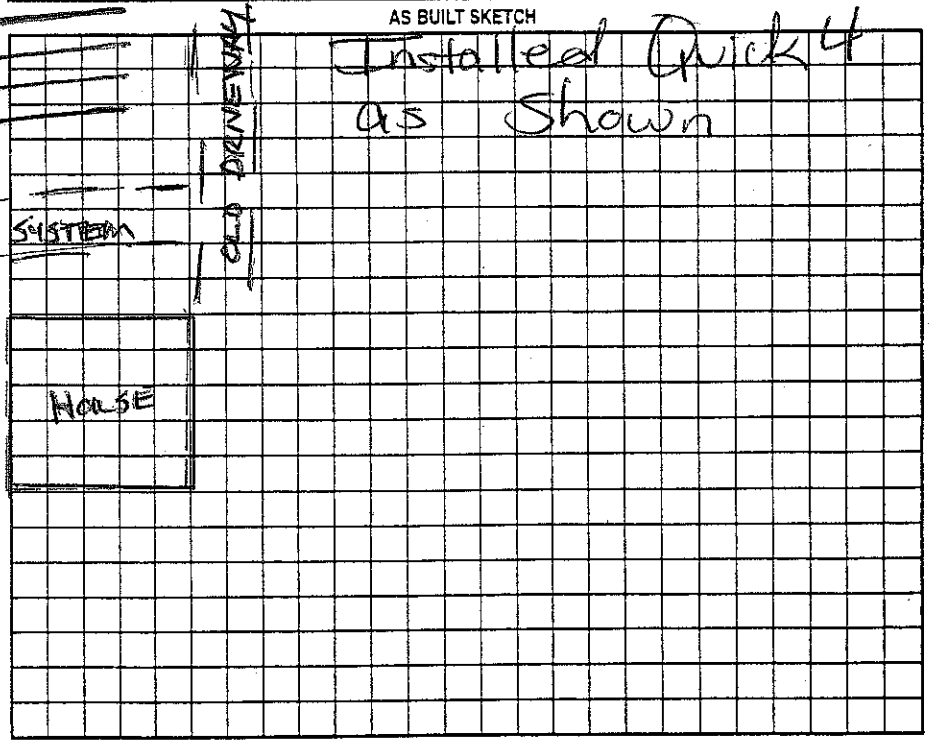

Permit can be suspended or revoked if any false information is supplied toward securing the permit/any unauthorized changes are made to the site/any unauthorized changes are made in the installation of the system. Improvement Permit with plat valid without expiration ☐ Improvement Permit with site plan valid for sixty months ☐ Authorization to Construct is valid for a period equal to that of Improvement Permit – not to exceed sixty months.

Signed: X [signature] date 6/26/06

Improvement Permit by: Wesley Sparks RS. date 6/26/06

Authorization to Construct by: Wesley Sparks RS date 6/26/06

Installed by: Curt Dunning

Operation Permit by: Wesley Sparks RS date 10/11/06

Existing System Inspection by: date

HEALTH DEPT. COPY: WHITE OWNER COPY (FINAL): YELLOW OWNER COPY (INITIAL): PINK