IREDELL COUNTY HEALTH DEPARTMENT

STATESVILLE 704-878-5305 MOORESVILLE 704-664-5281

IMPROVEMENT PERMIT / AUTHORIZATION TO CONSTRUCT / OPERATION PERMIT / EXISTING SYSTEM INSPECTION

PERMIT# 13850 & 13850 PIN# 4760 74 443 4760712720 Craig DATE 12-8-06

OWNER OR APPLICANT L&M Construction/Dirty Mo PHONE: Business 662-2204 Home

ADDRESS 137 Bridle Path Ln Mooresville NC 28117

LOCATION Hwy 21 N TR Shinnville Rd TR Snooter Rd (on right before Brawley Rd) at end Snooter 1202, 122

SUBDIVISION BLOCK / SECTION LOT Tract 2 LOT AREA 1.02 Acre SITE CLASS. PS DESIGN FLOW 450 gpd T.A.R. .4 (previous permit

Exist Septic Tank: 1000 Gallons: STB Date

Pump Tank: Gallons: PT Date

Pump Make: Model Serial No.

*Add to Exist. Drainfield Nitrification Field: No Fields 1 Square Feet 300 Linear Feet 100ft

No Lines 1 Trench Width 36" Max Trench Bottom Depth 36" Gravel Depth N/A ☒ Gravity ☐ Pressure

☐ New System ☐ Repair ☐ Expansion System Type: I II III IV V VI Addition

System Description: Gravity- Conventional / Accepted

Repair System Description: Innovative

Maintenance Agreement Required: ☐ Yes ☒ No

☒ House/Mod., Home ☐ Mobile Home ☐ Business ☒ Other Duplex

No. Bedrooms 4 No. Persons No. Employees


Water Supply: ☒ Individual ☐ Public ☐ Community

☐ Slab ☒ Crawl Space ☐ Basement w/plumbing ☐ Basement wo/plumbing

Comments/Conditions: Note: Use 25% Reduction Drainline.

Comments/Conditions: Upgrade System to 4 Bedroom Add 1 - line - 25% reduction @ 100ft Checked line

INITIAL SITE SKETCH *Not to Scale

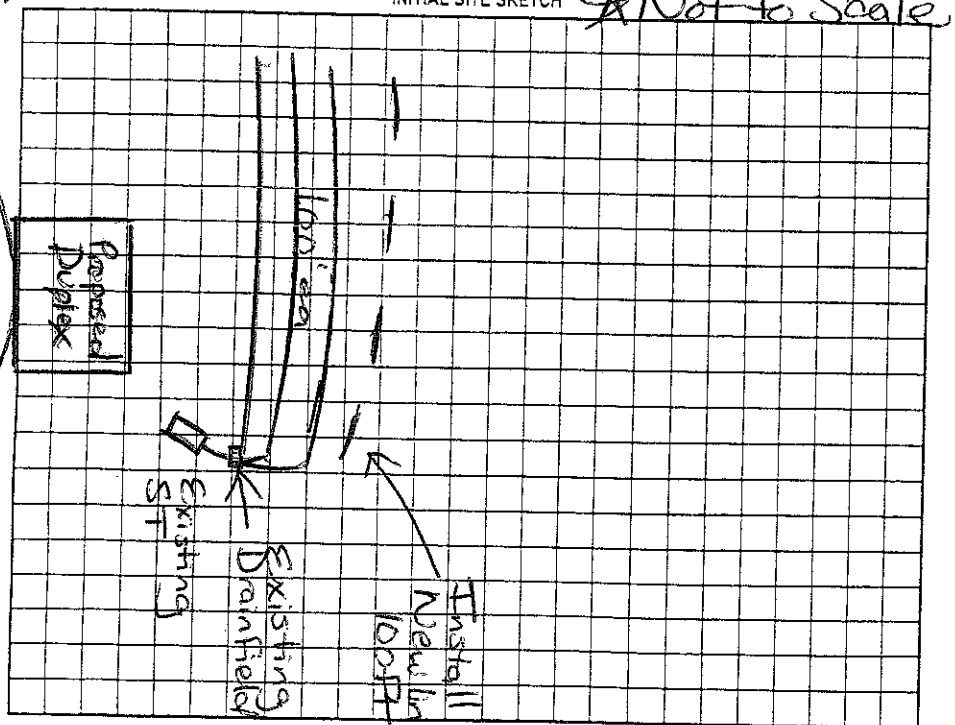

AS BUILT SKETCH

Original Permit attached
Septic System installed 1989
for Donald Benesik
Installed Quick 4 at new
Dist box

Permit can be suspended or revoked if any false information is supplied toward securing the permit/any unauthorized changes are made to the site/any unauthorized changes are made in the installation of the system. Improvement Permit with plat valid without expiration ☐ Improvement Permit with site plan valid for sixty months ☐ Authorization to Construct is valid for a period equal to that of Improvement Permit – not to exceed sixty months.

Signed: date 12/11/06 Installed by: Curt Dunning

Improvement Permit by: Maria H. Gibson RS date 12/8/06 Operation Permit by: Maria H. Gibson date 12/15/06

Authorization to Construct by: Maria H. Gibson RS date 12/8/06 Existing System Inspection by: date

HEALTH DEPT. COPY: WHITE OWNER COPY (FINAL): YELLOW OWNER COPY (INITIAL): PINK