IREDELL COUNTY HEALTH DEPARTMENT

4760736151 10:30-11:00 1:30

STATESVILLE 704-878-5305 MOORESVILLE 704-664-5281

IMPROVEMENT PERMIT / AUTHORIZATION TO CONSTRUCT / OPERATION PERMIT / EXISTING SYSTEM INSPECTION

PERMIT# 071162 PIN# 4760727677

OWNER OR CONTRACTOR Larry Howard DATE 1-9-98

ADDRESS 689 Brawley Rd. Cleveland, NC 27013 PHONE: Business 582-0188 Home (704) 664-3282

LOCATION 21 N to Shinnville Rd TR Shinnville Rd Just past Brawley Rd ~ 800' on left

SUBDIVISION _____ BLOCK / SECTION _____ LOT _____ LOT AREA Acreage (Pr 4.275 Acre) SITE CLASS. PS DESIGN FLOW 360gpd L.T.A.R. .275 - .3

Septic Tank: 1000 Gallons; STB 794 Date 3/12/98

Pump Tank: _____ Gallons; PT _____ Date _____

Pump Make: _____ Model _____ Serial No. _____

Nitrification Field: No Fields 1 Square Feet 1200' Linear Feet 400'

No Lines 5 at 80' Trench Width 36" Max Trench Bottom Depth 24" Gravel Depth 12"

☒ New System ☐ Repair System Type: I, (II), III, IV, V, VI

System Description: Gravel - Conventional

Repair System Description: Same

Maintenance Agreement Required: ☐ Yes ☒ No

☒ House/Mod. Home No. Bedrooms 3

☐ Mobile Home No. Bathrooms 2

☐ Business No. Employees ____

☐ Other _____

☐ Slab ☒ Crawl Space ☐ Basement w/plumbing ☐ Basement wo/plumbing

Water Supply: ☒ Individual ☐ Public ☐ Community


Comments:/Conditions: Tee 1st line into 2-40' lines

Keep Septic System 5' From House, 10' From Property Lines(PL) & 100' from Well


OK to move STB D-Box over (met w/ Installer 4/24/98) MD

Comments:/Conditions:

INITIAL SITE SKETCH Scale 1:100

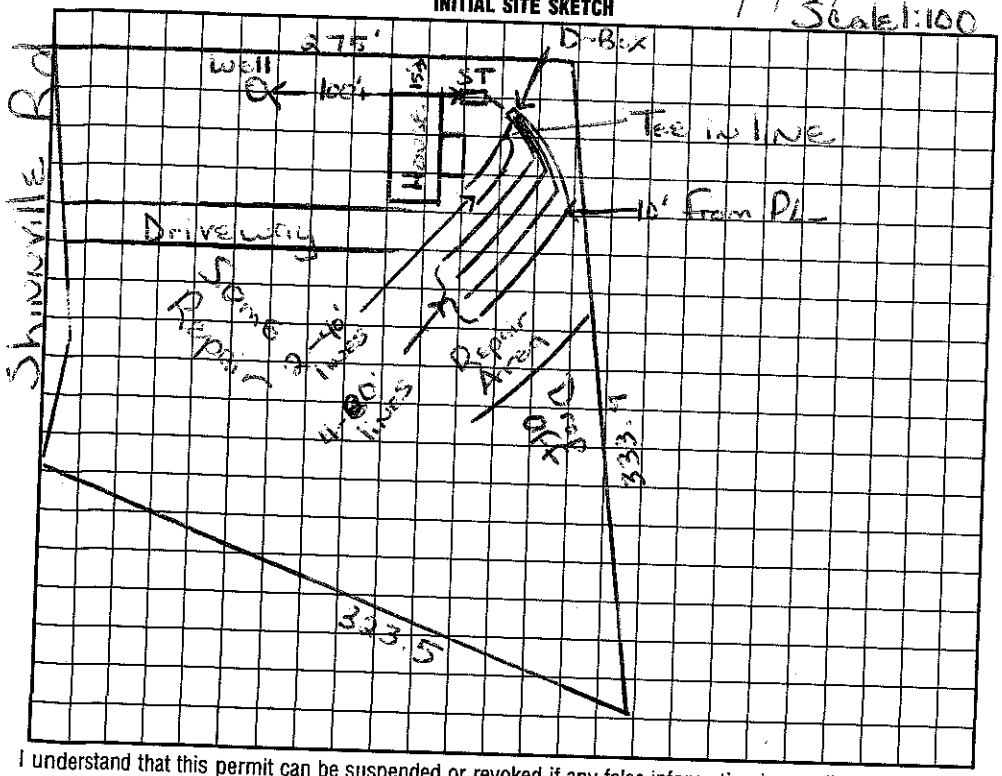

AS BUILT SKETCH

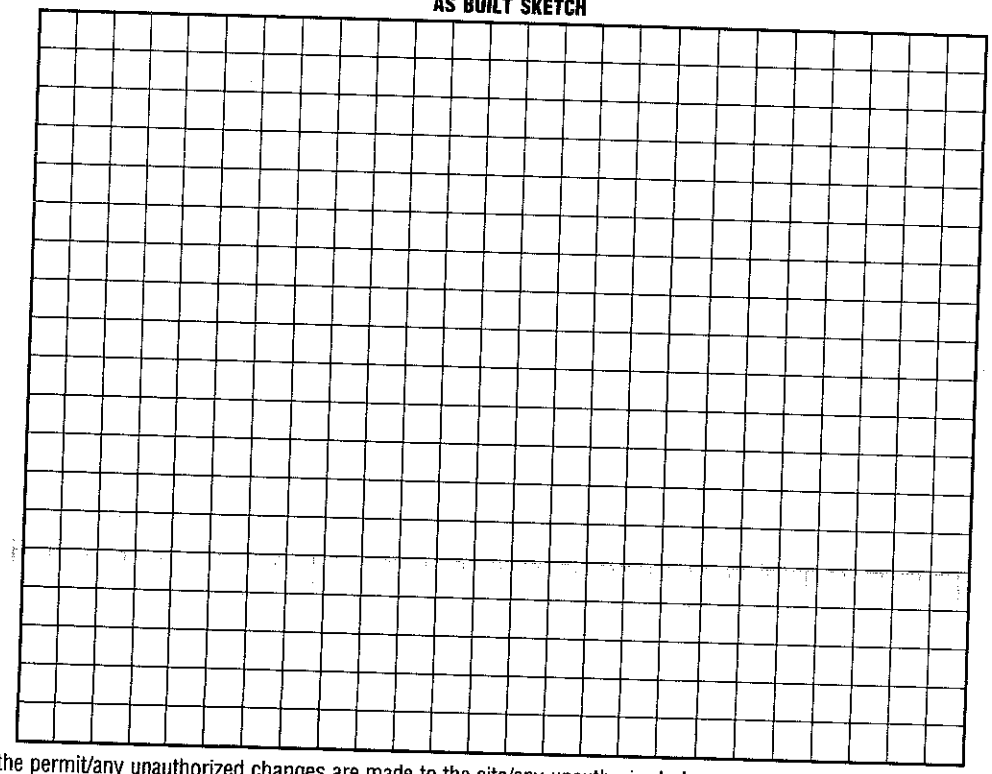

I understand that this permit can be suspended or revoked if any false information is supplied toward securing the permit/any unauthorized changes are made to the site/any unauthorized changes are made in the installation of the system. Improvement Permit with plat valid without expiration. Improvement Permit with site plan valid for sixty months. Authorization to Construct is valid for a period equal to that of Improvement Permit – not to exceed sixty months.

Signed: Larry Howard

Improvement Permit by: Marina H.H. Dotson date 1/12/98

Authorization to Construct by: Marina H.H. Dotson date 1/12/98

Installed by: ABERNATHY

Operation Permit by: _____ date 4/25/98

Existing System Inspection by: _____ date _____

HEALTH DEPT. COPY: WHITE INSPECTION COPY (FINAL): GREEN OWNER COPY (FINAL): YELLOW INSPECTION COPY (INITIAL): PINK OWNER COPY (INITIAL): GOLD