IREDELL COUNTY HEALTH DEPARTMENT

STATESVILLE 704-878-5305 MOORESVILLE 704-664-5281

IMPROVEMENT PERMIT / AUTHORIZATION TO CONSTRUCT / OPERATION PERMIT / EXISTING SYSTEM INSPECTION

PERMIT# 091793 PIN# 4760761662 Shane 622-9824 DATE 9-8-2000

OWNER OR CONTRACTOR Rex Edmonds PHONE: Business Home 528-3436

ADDRESS 154 Strawberry Hill Ln Cleveland, NC 27013

LOCATION Shinnville TJ Brawley TR Strawberry Hill Near End

SUBDIVISION BLOCK / SECTION LOT LOT AREA SITE CLASS. PS DESIGN FLOW 360 gpd A.R.

Septic Tank: ~~450~~ 1250 Gallons; STB Date

Pump Tank: Exist Gallons; PT WP250 Date

Pump Make: Model Serial No.

Nitrification Field: No Fields 1 Square Feet 900 Linear Feet 300'

No Lines 3 Trench Width 36" Max Trench Bottom Depth Gravel Depth 12"

☐ New System ☐ Repair System Type: I, II, III, IV, V, VI

System Description: Addition Gravity Convention

Repair System Description:

Maintenance Agreement Required: ☐ Yes ☒ No

☒ House/Mod. Home No. Bedrooms 3

☐ Mobile Home + Garage Office No. Bathrooms 2.5

☐ Business No. Employees

☐ Other


☐ Slab ☐ Crawl Space ☐ Basement w/plumbing ☐ Basement wo/plumbing

Water Supply: ☒ Individual ☐ Public ☐ Community


Comments:/Conditions: Existing Septic System appears to be functioning okay at time of inspection, no problems noticed.

Comments:/Conditions: Okay to add proposed Building to Existing Septic System (May have to use grinder pump)

INITIAL SITE SKETCH ☆ Not to Scale

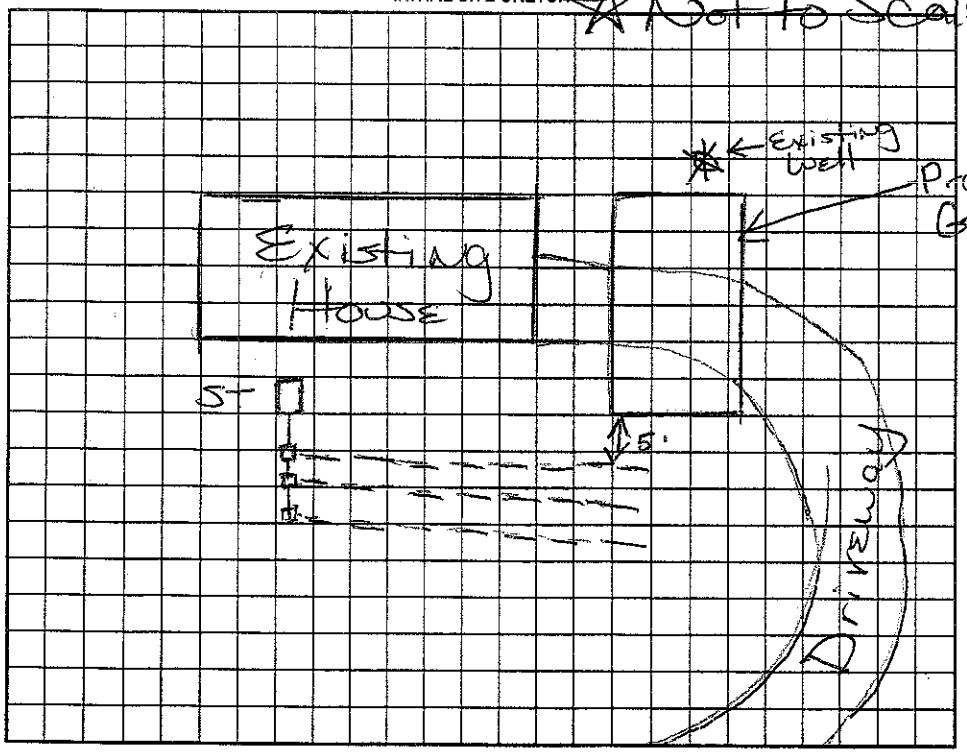

AS BUILT SKETCH

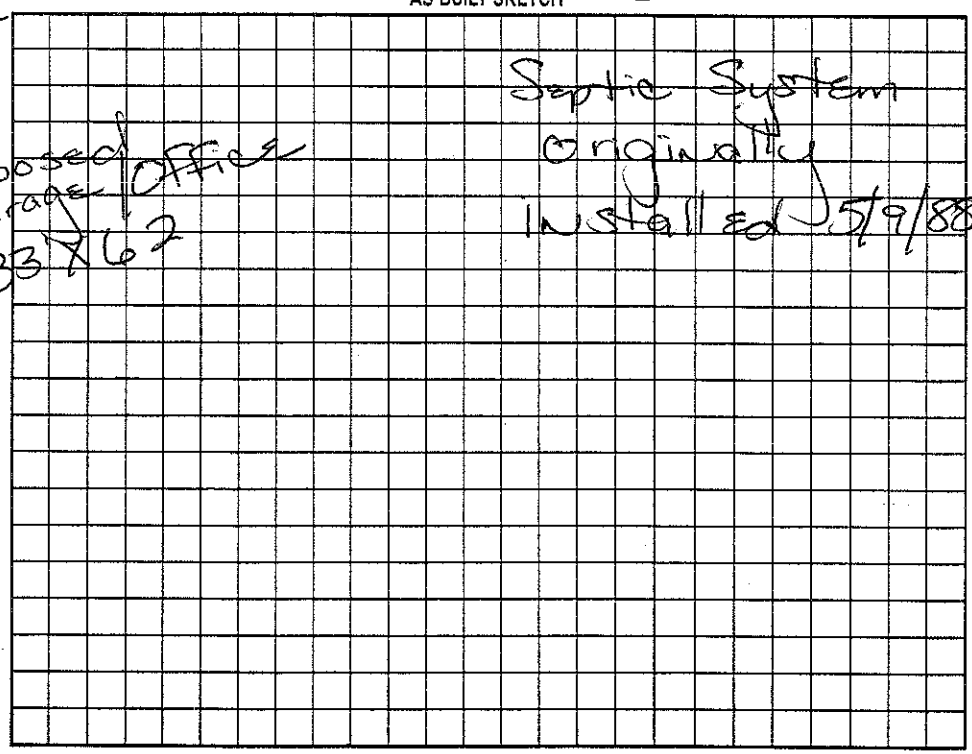

Permit can be suspended or revoked if any false information is supplied toward securing the permit/any unauthorized changes are made to the site/any unauthorized changes are made in the installation of the system. Improvement Permit with plat valid without expiration. Improvement Permit with site plan valid for sixty months. Authorization to Construct is valid for a period equal to that of Improvement Permit – not to exceed sixty months.

Signed: date 8 Sep 00 Installed by:

Improvement Permit by: Maina M Dotson RS date 9/8/2000 Operation Permit by: date

Authorization to Construct by: date Existing System Inspection by: Maina M Dotson RS date 9/8/2000

☆ Pd $50.00 9/8/2000

HEALTH DEPT COPY: WHITE OWNER COPY (FINAL): YELLOW OWNER COPY (INITIAL): PINK