IREDELL COUNTY HEALTH DEPARTMENT

STATESVILLE 704-878-5305 MOORESVILLE 704-664-5281

IMPROVEMENT PERMIT / AUTHORIZATION TO CONSTRUCT / OPERATION PERMIT / EXISTING SYSTEM INSPECTION

PERMIT# 074961 PIN# 4760 78 0197 DATE 6/9/01

OWNER OR CONTRACTOR Michael Hill PHONE: Business Home 892-1823

ADDRESS Hidden Hill Ln. Troutman, NC. 28166

LOCATION Shimsville Rd. TL Brawley Rd, TR Hidden Hill Ln. to near end on (R)

SUBDIVISION No BLOCK / SECTION LOT LOT AREA No SITE CLASS. RS DESIGN FLOW 360 L.T.A.R. .3

Septic Tank: 1000 Gallons; STB 1009 Date 4/2/01
Pump Tank: Gallons; PT Date
Pump Make: Model Serial No.
Nitrification Field: No Fields 1 Square Feet 1200 Linear Feet 400
No Lines 4@100 Trench Width 3' Max Trench Bottom Depth 3'

[X] New System [ ] Repair System Type: I, II, III, IV, V, VI
System Description: Gravity-Conventional
Repair System Description: Same
Maintenance Agreement Required: [ ] Yes [X] No


[X] House/Mod. Home No. Bedrooms 3
[ ] Mobile Home No. Bathrooms 3
[ ] Business No. Employees
[ ] Other
Gravel Depth 12" [ ] Slab [X] Crawl Space [ ] Basement w/plumbing [ ] Basement wo/plumbing

Water Supply: [X] Individual [ ] Public [ ] Community


Comments:/Conditions:

Comments:/Conditions:

INITIAL SITE SKETCH

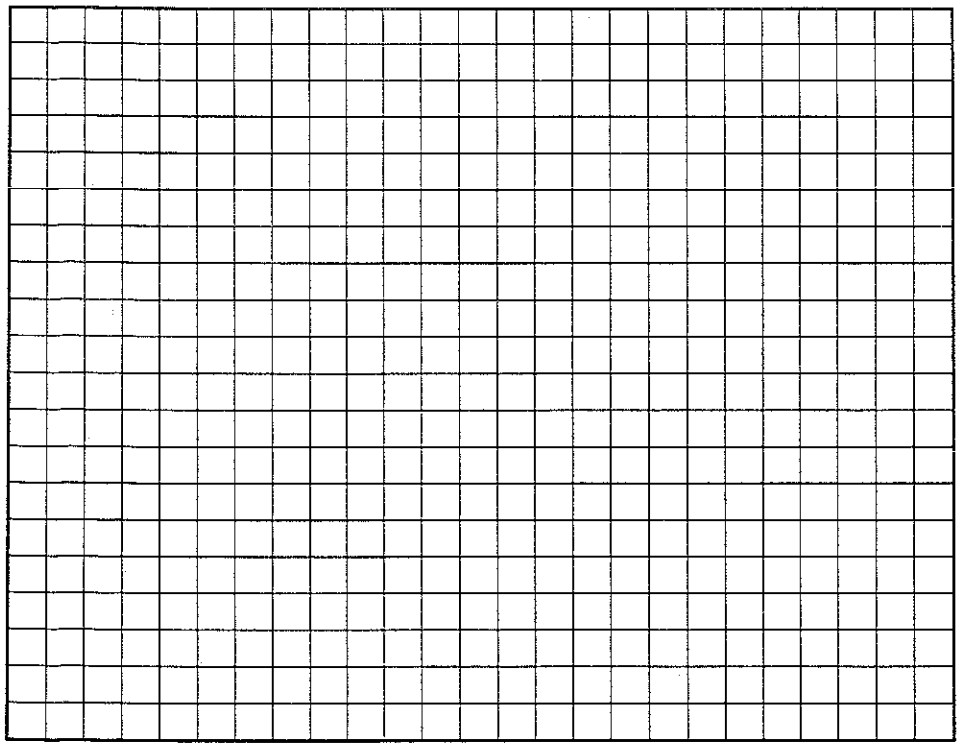

AS BUILT SKETCH

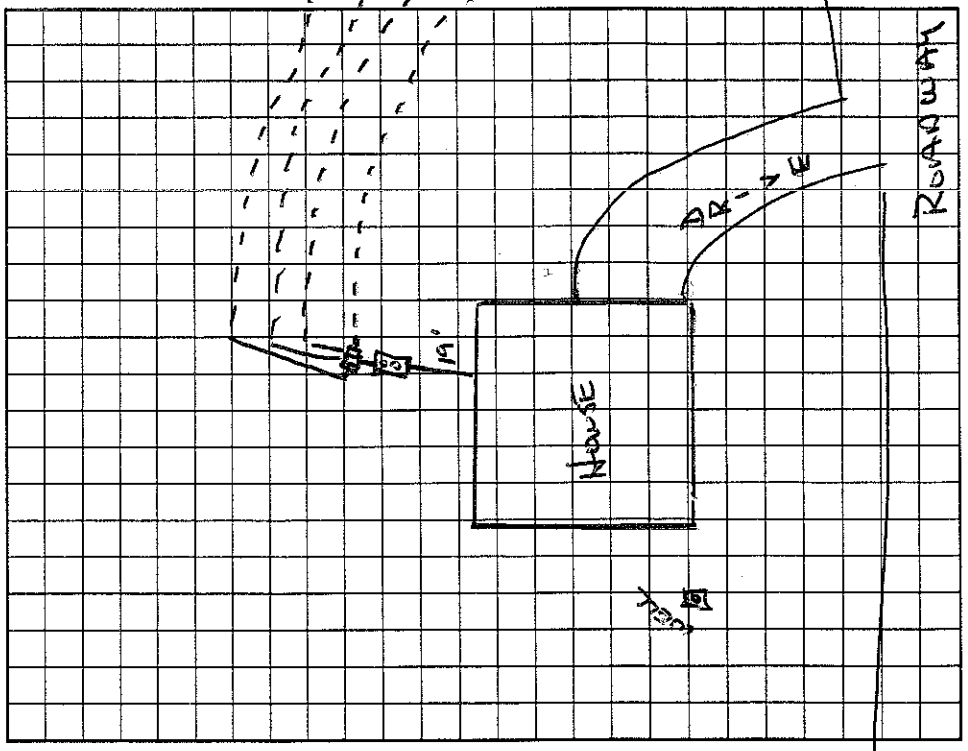

Permit can be suspended or revoked if any false information is supplied toward securing the permit/any unauthorized changes are made to the site/any unauthorized changes are made in the installation of the system. Improvement Permit with plat valid without expiration. Improvement Permit with site plan valid for sixty months. Authorization to Construct is valid for a period equal to that of Improvement Permit – not to exceed sixty months.

Signed: date Installed by: K+M Grading and Backhoe

Improvement Permit by: date Operation Permit by: Wesley Sparks RS, date 7/10/01

Authorization to Construct by: date Existing System Inspection by: Wesley Sparks RS. date 7/10/01

HEALTH DEPT. COPY: WHITE OWNER COPY (FINAL): YELLOW OWNER COPY (INITIAL): PINK