IREDELL COUNTY HEALTH DEPARTMENT

4760835191

STATESVILLE 704-878-5305 MOORESVILLE 704-664-5281

IMPROVEMENT PERMIT / CERTIFICATE OF COMPLETION / OPERATION PERMIT / EXISTING SYSTEM INSPECTION

PROPERTY DESCRIPTION NO. 19705 DATE 1/17/95 TAX MAP NO. 4H-B-73 Pt of. Watershed: ☑ Yes ☐ No

OWNER OR CONTRACTOR Randy Hunlocker / Pam Miller PHONE: Business _____ Home 664-0893

ADDRESS 525 Deadright St. Mooresville, NC. 28115

LOCATION Shinnville Rd, ~ 3 miles on ⓛ from 115

SUBDIVISION No BLOCK / SECTION _____ LOT _____ LOT AREA ~ 3 acres SITE CLASS. P DESIGN FLOW 480 L.T.A.R. .30

Septic Tank: 1000 Gallons; STB 794 Date 9/12/97

Pump Tank: _____ Gallons; PT _____ Date _____

Pump Make: _____ Model _____ Serial No. _____

Nitrification Field: No Fields 1 Square Feet 1600 Linear Feet 533

No Lines 5 Trench Width 36" Max Trench Bottom Depth 36" Gravel Depth 12"

☑ New System ☐ Repair System Type: I, ⓘ, III, IV, V, VI

System Description: Conv - Dist Box

Repair System Description: _____

Maintenance Agreement Required: ☐ Yes ☑ No

☑ House/Mod. Home No. Bedrooms 4

☐ Mobile Home No. Bathrooms 3

☐ Business No. Employees _____

☐ Other _____

☐ Slab ☐ Crawl Space ☐ Basement w/plumbing ☑ Basement wo/plumbing

Water Supply: ☑ Individual ☐ Community ☐ Public


Comments:

Lines on slope shown. ↑ REPAIR AREA contains one area


Comments:

well

INITIAL SITE SKETCH

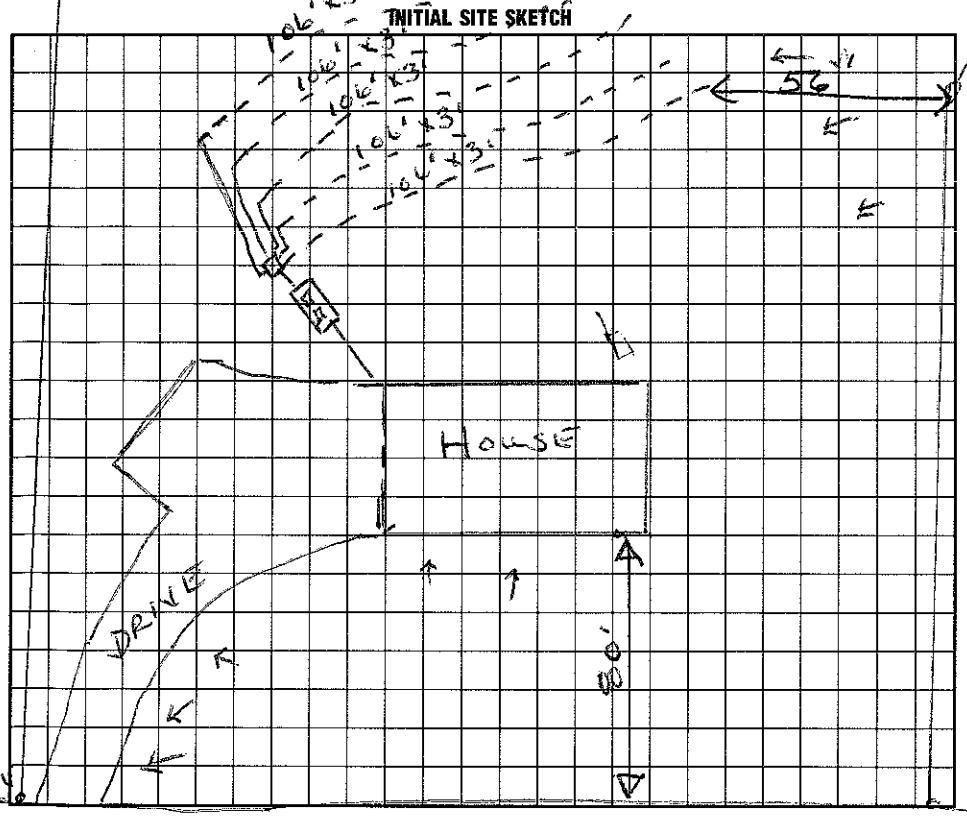

AS BUILT SKETCH

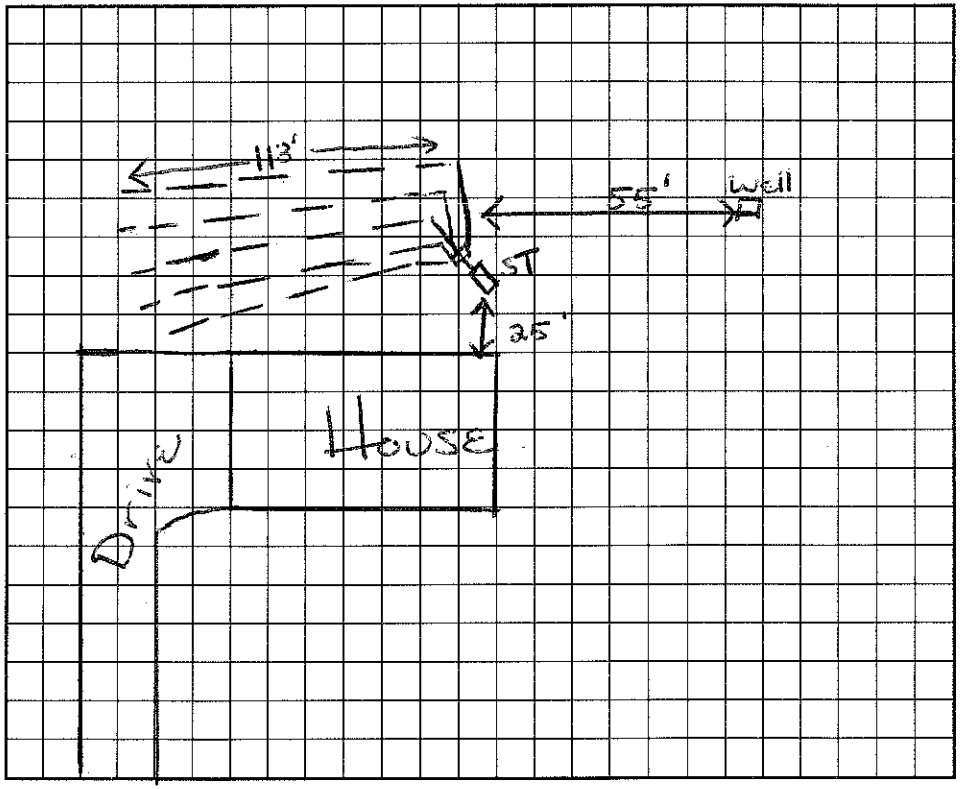

I understand that this permit can be suspended or revoked if any false information is supplied toward securing the permit/any unauthorized changes are made to the site/any unauthorized changes are made in the installation of the system. Improvement Permit is valid for 60 months from date of issuance.

Signed: Pam Miller

Improvement Permit by: Wayne Sparks RS date 1/19/95

Existing System Inspection by: _____ date _____

Installed by: F.J. Ervin

Certificate of Completion by: Marion H. Dotson date 12/3/97

Operation Permit by: Marion H. Dotson date 12/3/97

HEALTH DEPT. COPY: WHITE INSPECTION COPY (FINAL): GREEN OWNER COPY (FINAL): YELLOW INSPECTION COPY (INITIAL): PINK OWNER COPY (INITIAL): GOLD