4760835191

IREDELL COUNTY HEALTH DEPARTMENT

STATESVILLE 704-878-5305 MOORESVILLE 704-664-5281

IMPROVEMENT PERMIT / CERTIFICATE OF COMPLETION / OPERATION PERMIT / EXISTING SYSTEM INSPECTION

PROPERTY DESCRIPTION NO. 19765 DATE 1/17/95 TAX MAP NO. 4H-B-73 pt of.

OWNER OR CONTRACTOR Randy Heylocker / Pam Miller PHONE: Business ______ Home 664-0893 Watershed: ☑ Yes ☐ No

ADDRESS 525 Doodnight St. Mooresville, NC. 28115

LOCATION Shearersville Rd, ~ 3 miles on (L) from 115

SUBDIVISION No BLOCK / SECTION ______ LOT ______ LOT AREA ~ 3 acres SITE CLASS. P DESIGN FLOW 480 L.T.A.R. .35

Septic Tank: 1000 Gallons; STB 794 Date 9/12/97

Pump Tank: ______ Gallons; PT ______ Date ______

Pump Make: ______ Model ______ Serial No. ______

Nitrification Field: No Fields 1 Square Feet 1600 Linear Feet 533

No Lines 5 Trench Width 36" Max Trench Bottom Depth 36" Gravel Depth 12"

☑ New System ☐ Repair System Type: I (II) III, IV, V, VI

System Description: CONV - DIST BOX

Repair System Description: ______

Maintenance Agreement Required: ☐ Yes ☑ No

☑ House/Mod. Home ☐ Mobile Home ☐ Business ☐ Other ______

No. Bedrooms 4 No. Bathrooms 3 No. Employees ______


Water Supply: ☑ Individual ☐ Community ☐ Public

☐ Slab ☐ Crawl Space ☐ Basement w/plumbing ☑ Basement wo/plumbing


Comments: Lines on slope shown. REPAIR AREA contours in area

Comments: Well

INITIAL SITE SKETCH

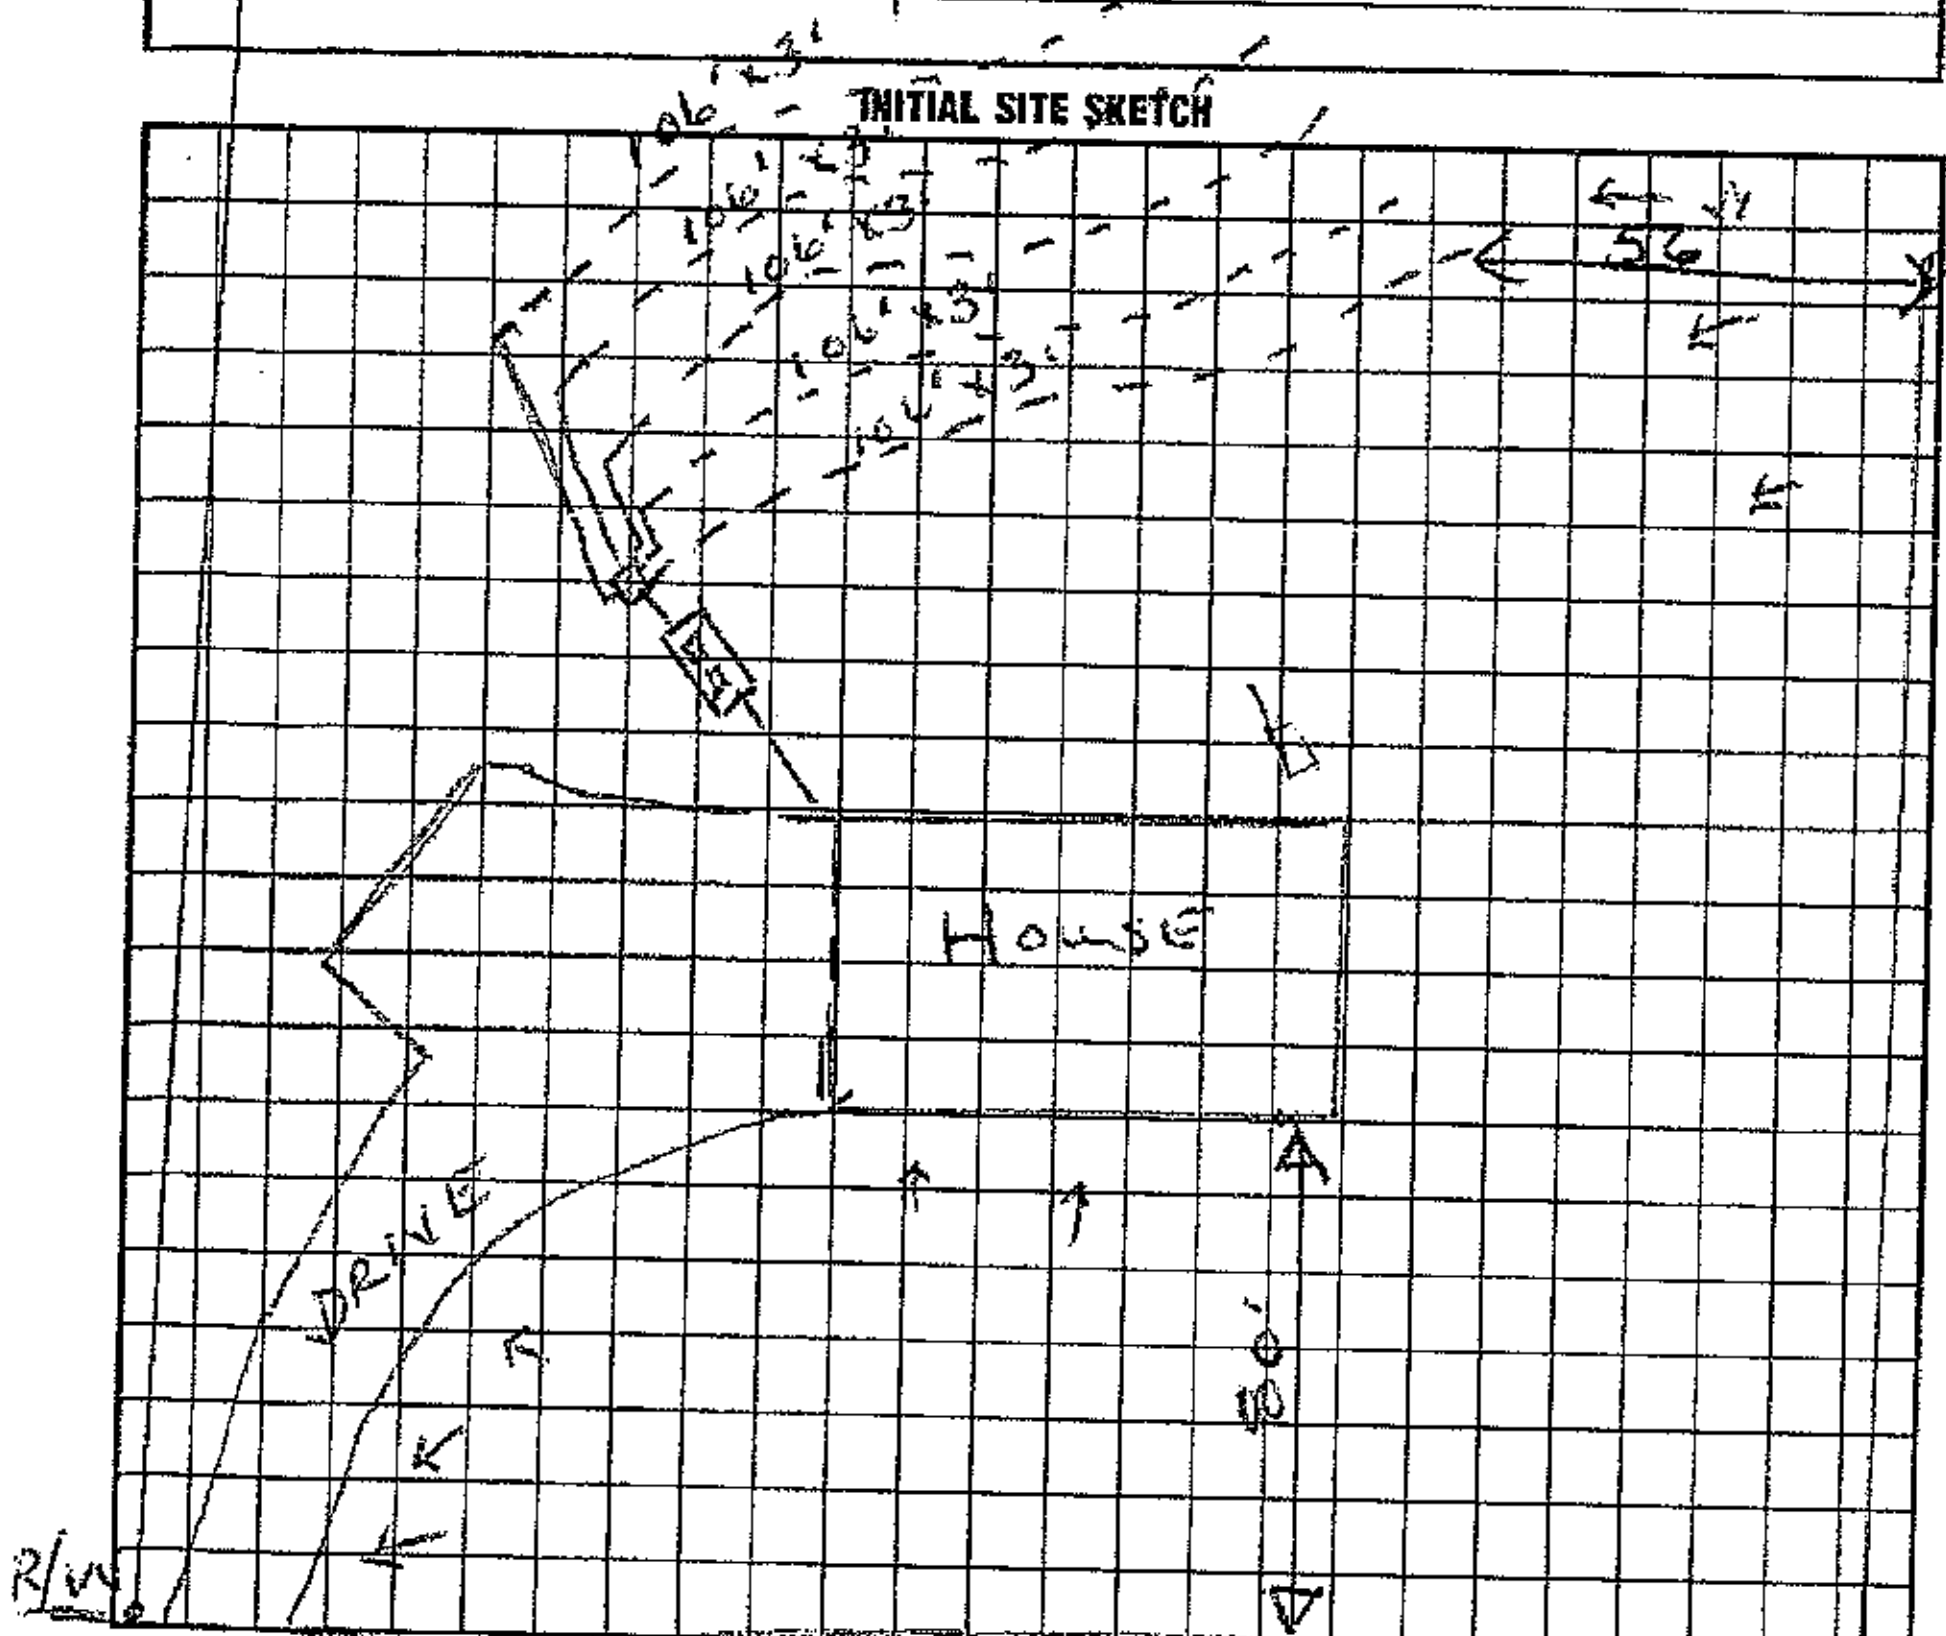

AS BUILT SKETCH

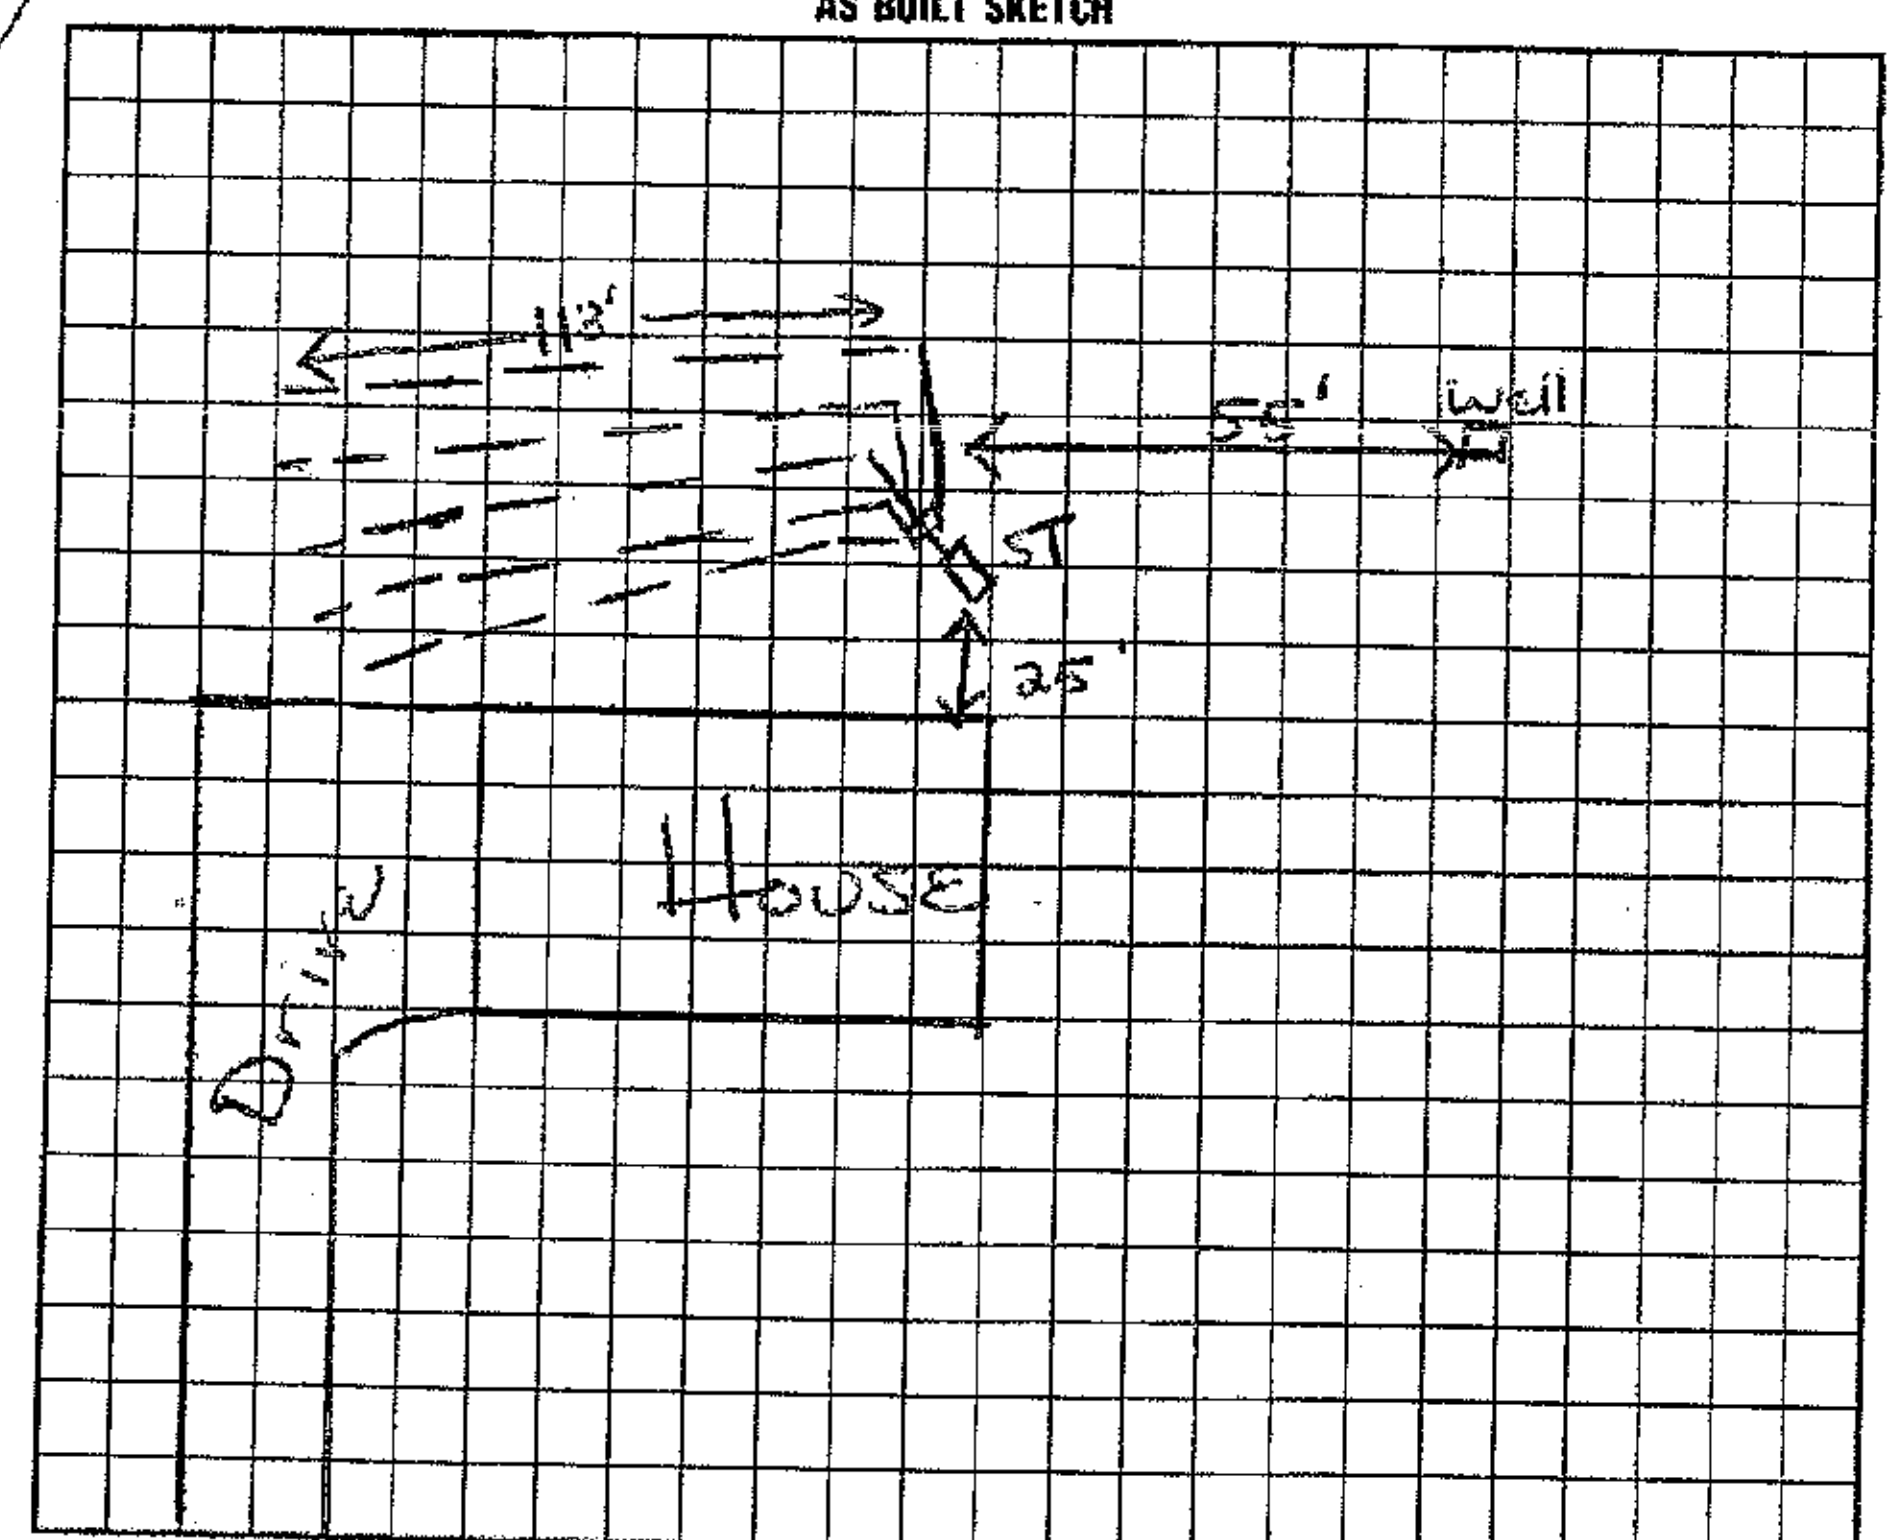

I understand that this permit can be suspended or revoked if any false information is supplied toward securing the permit/any unauthorized changes are made to the site/any unauthorized changes are made in the installation of the system. Improvement Permit is valid for 60 months from date of issuance.

Signed: Pam Miller

Improvement Permit by: Wesley Sparks RS date 1/19/95

Existing System Inspection by: ______ date ______

Installed by: F.J. Ervin

Certificate of Completion by: [signature] date 12/3/97

Operation Permit by: [signature] date 12/3/97

HEALTH DEPT. COPY: WHITE INSPECTION COPY (FINAL): GREEN OWNER COPY (FINAL): YELLOW INSPECTION COPY (INITIAL): PINK OWNER COPY (INITIAL): GOLD