Upright

IREDELL COUNTY HEALTH DEPARTMENT

STATESVILLE 704-878-5305 MOORESVILLE 704-664-5281

IMPROVEMENT PERMIT / AUTHORIZATION TO CONSTRUCT / OPERATION PERMIT / EXISTING SYSTEM INSPECTION

PERMIT# 88312 PIN# ~~4760 96647 PT~~ 4760859513 DATE 3/16/00

OWNER OR CONTRACTOR OVERCASH LAND & DEV. PHONE: Business 525-2529 Home

ADDRESS PO BOX 3846 MOORESVILLE NC 28117

LOCATION 115 N - TR SHINNVILLE RD - TL SONOMA DRIVE - AT END ON RT

SUBDIVISION SHINNVILLE EST. BLOCK / SECTION I LOT #9 LOT AREA 1.46AC SITE CLASS. PS DESIGN FLOW 360gpd L.T.A.R. .3gal/sqft

Septic Tank: 1000 Gallons; STB 312 Date 7/2/00
Pump Tank: Gallons; PT Date
Pump Make: Model Serial No.
Nitrification Field: No Fields 1 Square Feet 1260 Linear Feet 420
No Lines 6@70' Trench Width 36" Max Trench Bottom Depth 36" Gravel Depth 12"

☑ New System ☐ Repair System Type: I, II, III, IV, V, VI
System Description: GRAVITY CONVENTIONAL
Repair System Description: SAME
Maintenance Agreement Required: ☐ Yes ☑ No


☐ House/Mod. Home No. Bedrooms 3
☑ Mobile Home No. Bathrooms 2
☐ Business No. Employees
☐ Other
☐ Slab ☑ Crawl Space ☐ Basement w/plumbing ☐ Basement wo/plumbing

Water Supply: ☑ Individual ☐ Public ☐ Community

Comments:/Conditions: ~~@~~ KEEP WELL 100' FROM ANY SEPTIC SYSTEM

9-21-00 Reviewed floor plan; house is longer (68') than shown on IP - Shift system accordingly.


INITIAL SITE SKETCH

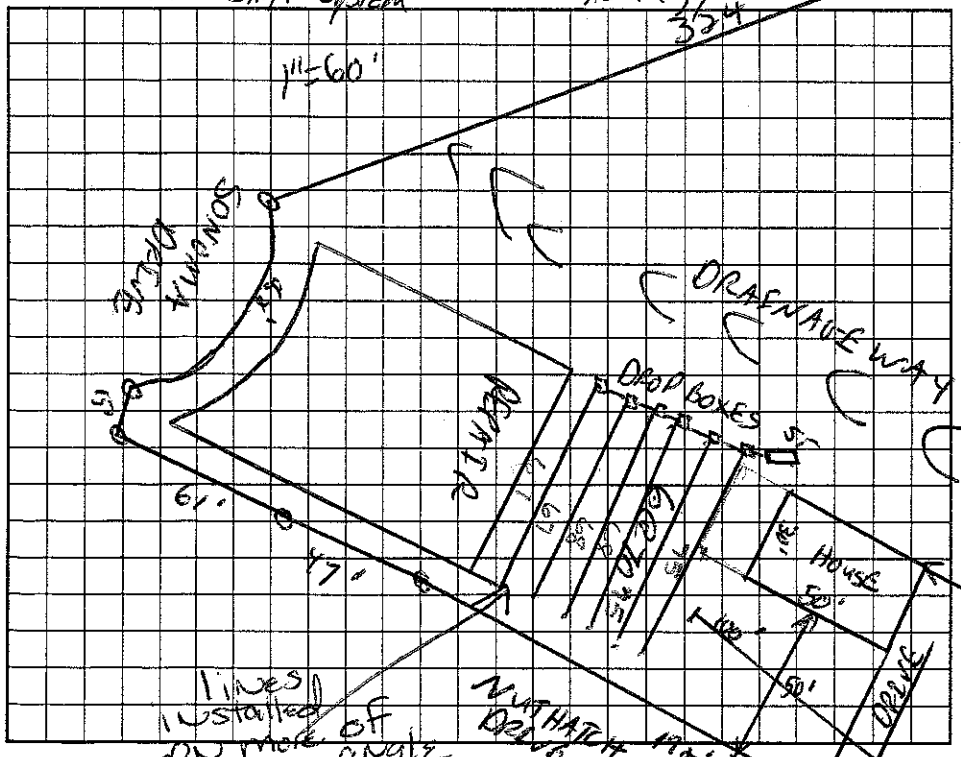

Comments:/Conditions: Riser & ST marker installed

Zabal filter installed

AS BUILT SKETCH

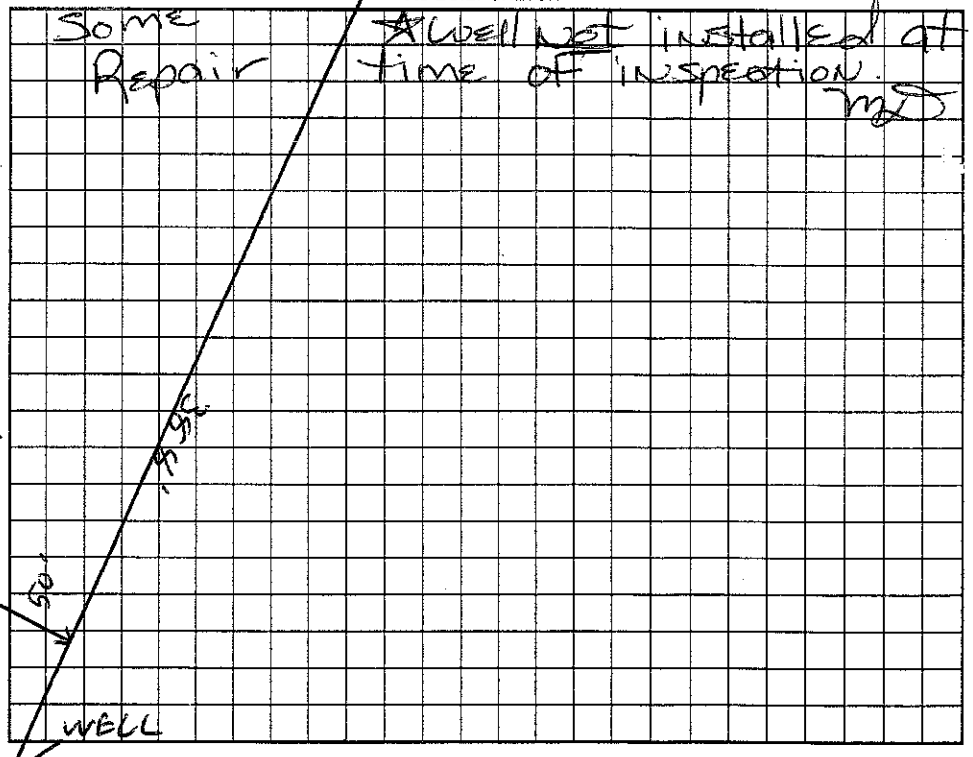

Permit can be suspended or revoked if any false information is supplied toward securing the permit/any unauthorized changes are made to the site/any unauthorized changes are made in the installation of the system. Improvement Permit with plat valid without expiration. Improvement Permit with site plan valid for sixty months. Authorization to Construct is valid for a period equal to that of Improvement Permit - not to exceed sixty months.

Signed: Kayo Overcash date

Improvement Permit by: C. Myers RS date 3/16/00

Authorization to Construct by: [signature] RS date 9-21-00

Installed by: Upright Grading

Operation Permit by: Marvin H. Robertson B.S date 10/31/2000

Existing System Inspection by: date

HEALTH DEPT. COPY: WHITE OWNER COPY (FINAL): YELLOW OWNER COPY (INITIAL): PINK